


6-9423  
63602

T.37S., R9E., W.M

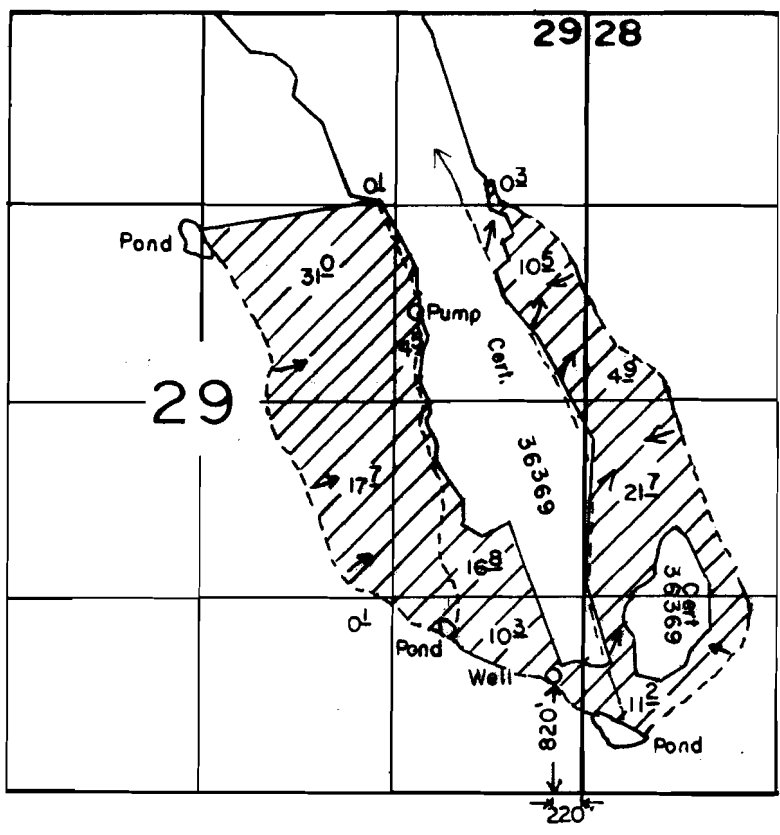

SCALE: 1" = 1320'

### FINAL PROOF SURVEY UNDER

Application No. G-9.8.93. Permit No. G-9.42.3....  
IN NAME OF

.....LARRY C. HEATON.....

Surveyed MAY. 26. 1989., by R.W. BISHOP.....