


T.19S., R. 42 & 43E., W.M.

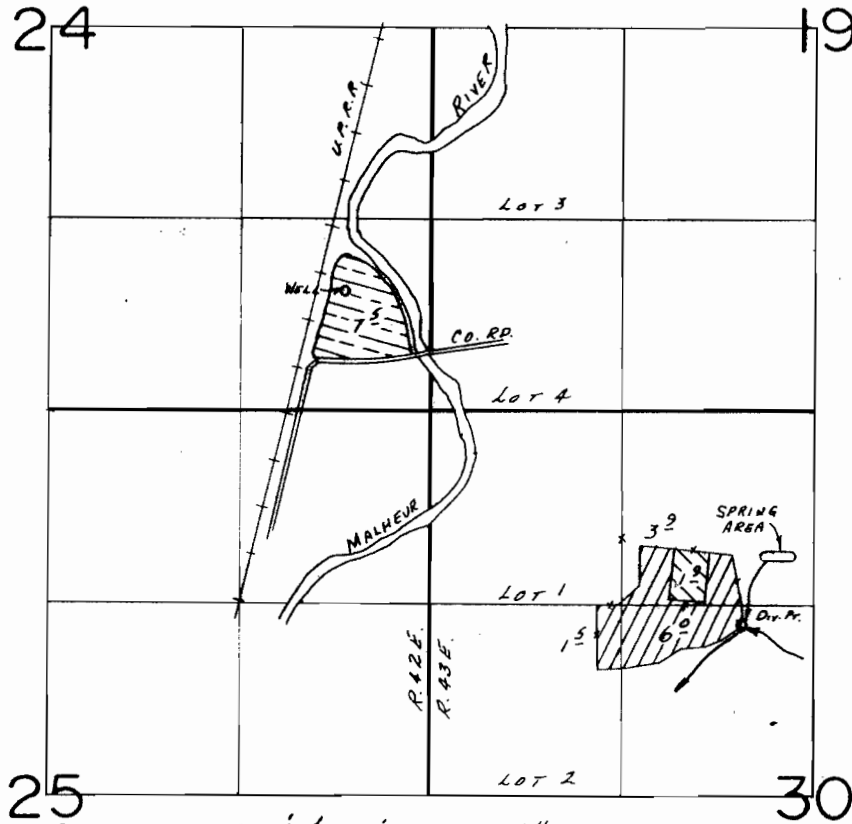

SCALE: 1" = 1320'

DIV. PT. LOC.: 1470 S. & 490 W. FROM N 1/4 COR. SEC. 30
 WELL LOC.: 820 N. & 600 W. FROM SE COR. SEC. 24.

Primary
 G-10725
 Supplemental

FINAL PROOF SURVEY
 UNDER

G-10725 G-9891
 Application No. 63555... Permit No. 47206.....
 IN NAME OF

.....EVELYN SEIDERS.....

Surveyed ..May.2.... 1986, by L.M.TOLL.....

3/24/87
 PTS 1986V-A
 41045-178-71R