
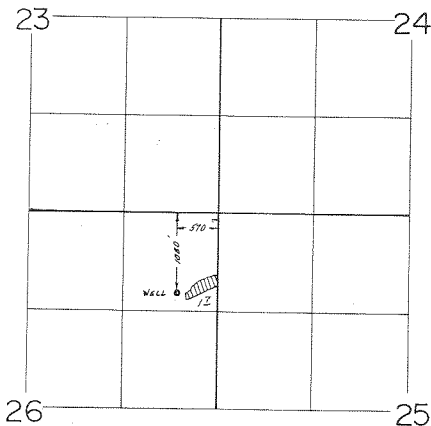


T. 15., R. 12E., W.M.

 

SCALE: 1" = 1320'

**FINAL PROOF SURVEY**  
UNDER

Application No. G:10744 Permit No. G:9988...  
IN NAME OF

.....FRANK W. GROVES.....

Surveyed Aug. 12, 19.87, by V.L. CHURCH.....

*4/1/88*  
41045-472-264