


T.14S., R.15E., W.M.

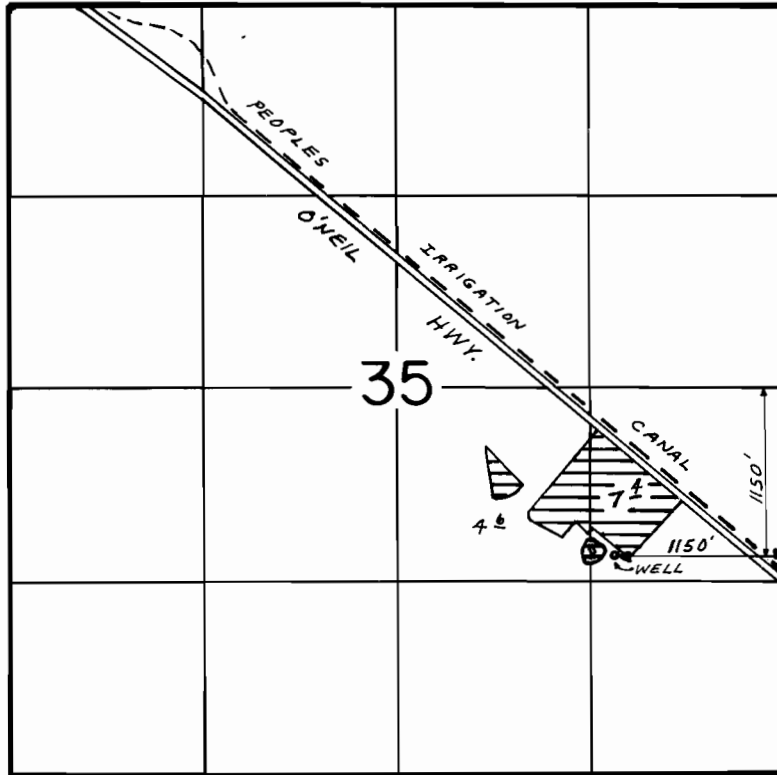

SCALE: 1" = 1320'

FINAL PROOF SURVEY UNDER

Application No. G-10794 Permit No. G 9884

IN NAME OF

LIEF AND DAWN GILBERTSON

Surveyed Oct. 7, 1987, by M. J. MATTICK