


T. 36 S., R. 2 W., W. M.

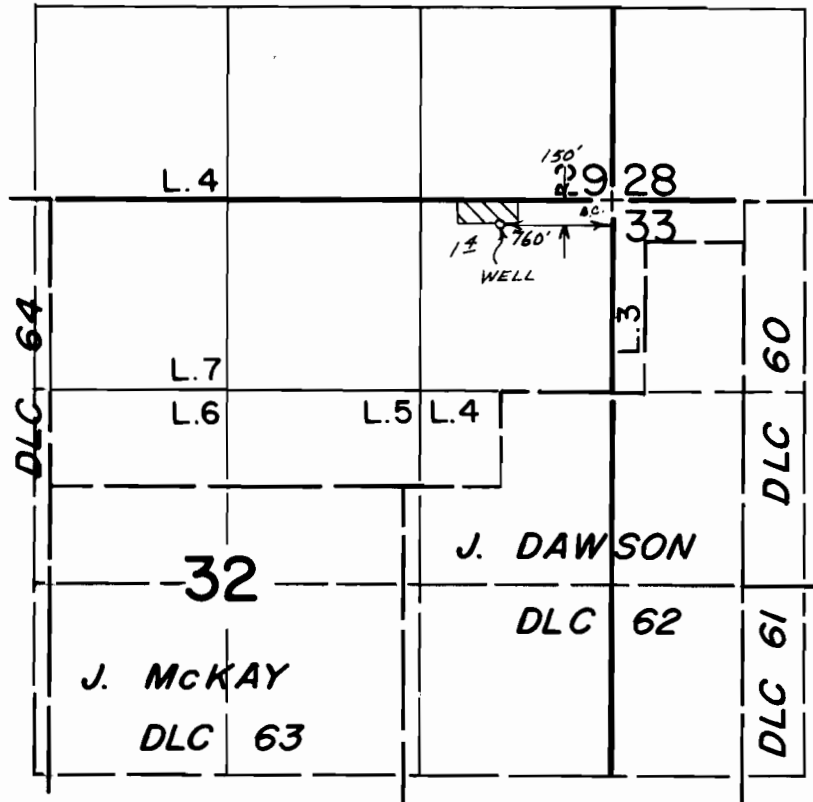

Scale: 1" = 1320'

FINAL PROOF SURVEY UNDER

Application No. G-10808 Permit No. G-9905....
IN NAME OF

CARROLL E. STEVENSON

Surveyed JUNE 11, 1987, by B.S. JAMES.....