


T. 6 S., R. 2 W., W. M.

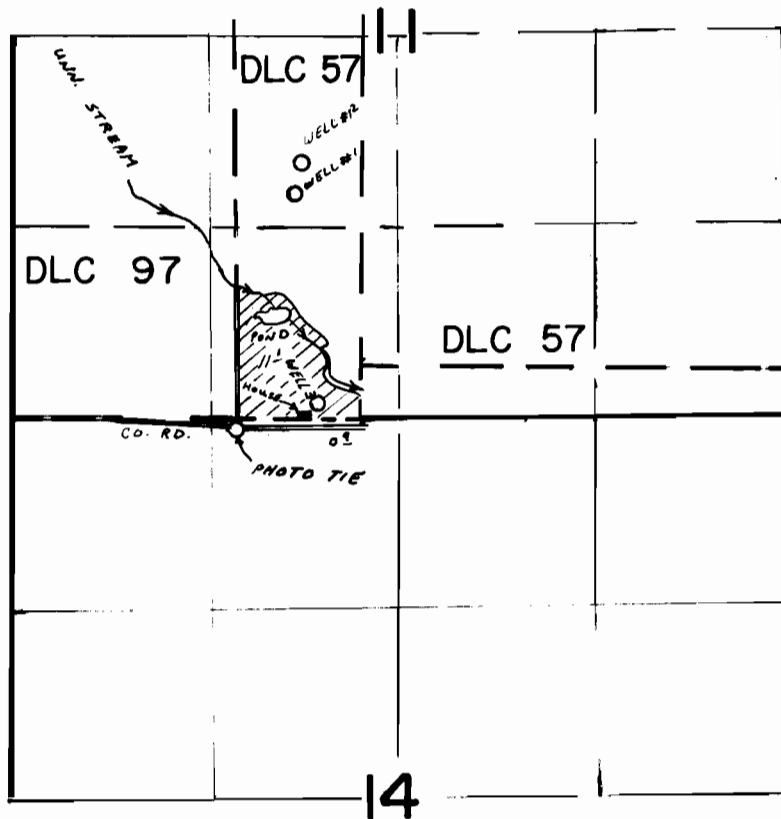

WELL 3 : 100' N. AND 560' W.
 WELL 2 : 1780' N. AND 660' W. ALL FROM S 1/4 CORNER SEC. 11
 WELL 1 : 1560' N. AND 785' W.

SCALE 1" = 1320'

FINAL PROOF SURVEY UNDER

Application No. G-10872 Permit No. G-10093
 IN NAME OF

DARLENE HENNY

Surveyed APR 12 88 by Z. SALEH
 19....., by