


T. 26 S., R. 16 E., W. M.

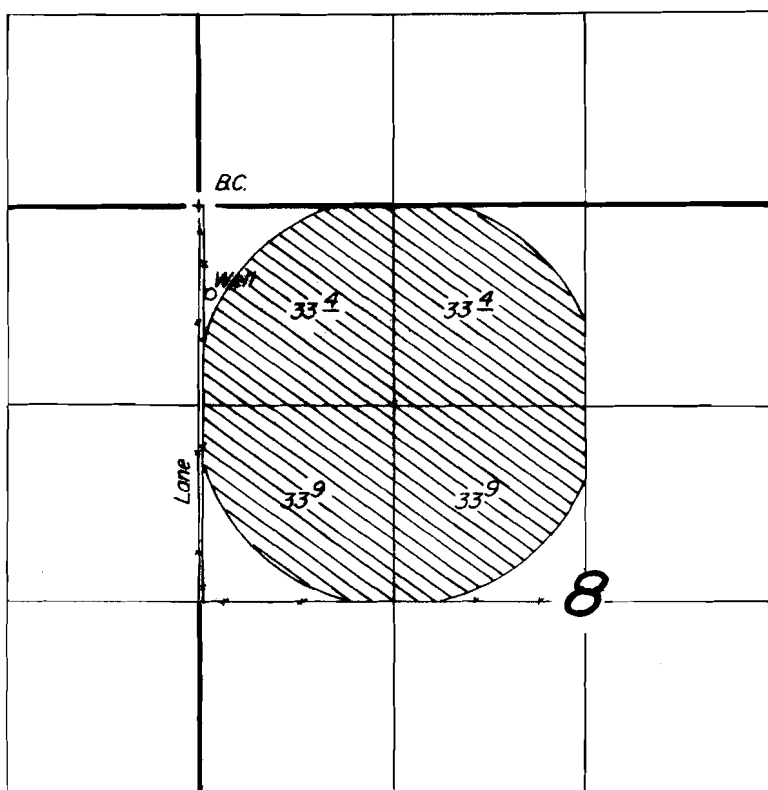

Well Located: 600' S. & 80' E. from NW Cor. Sec. 8.

Scale: 1" = 1320'

FINAL PROOF SURVEY

UNDER

Application No. G-10937 Permit No. G-10061

IN NAME OF

JOHN KEVIN O'LEARY

Surveyed Oct. 10, 1985, by T. Warren