


T.2N., R.13E., W.M.

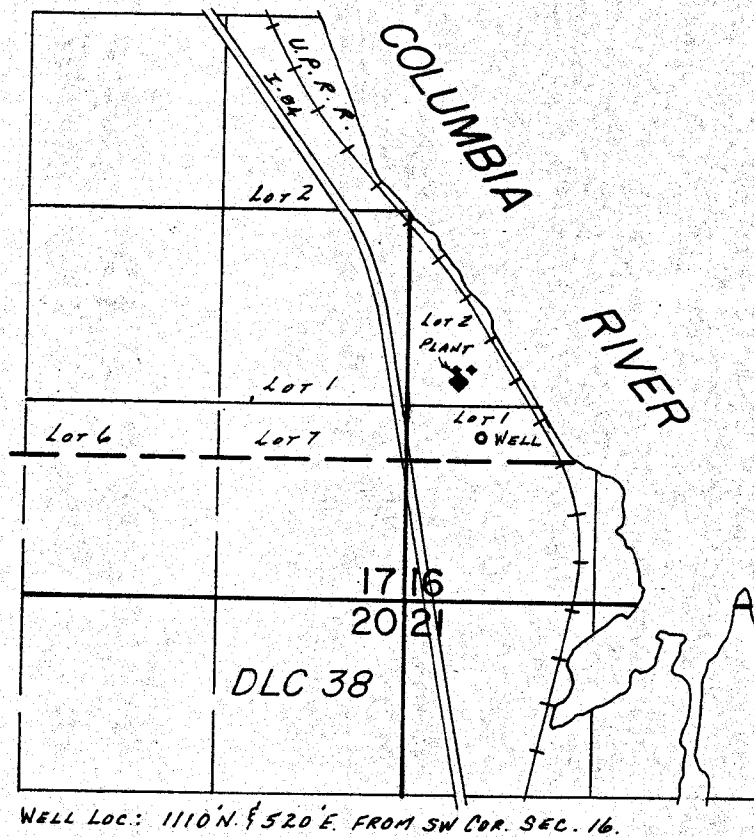

SCALE: 1" = 1320'

FINAL PROOF SURVEY UNDER

Application No. G-11053 Permit No. G-10355
IN NAME OF

.....MERLE M. HENKLE.....

Surveyed NOV. 17, 1987, by V.L. CHURCH...

2-12-88 HWS
41065-572-38