


T.9S., R.3W., W.M.

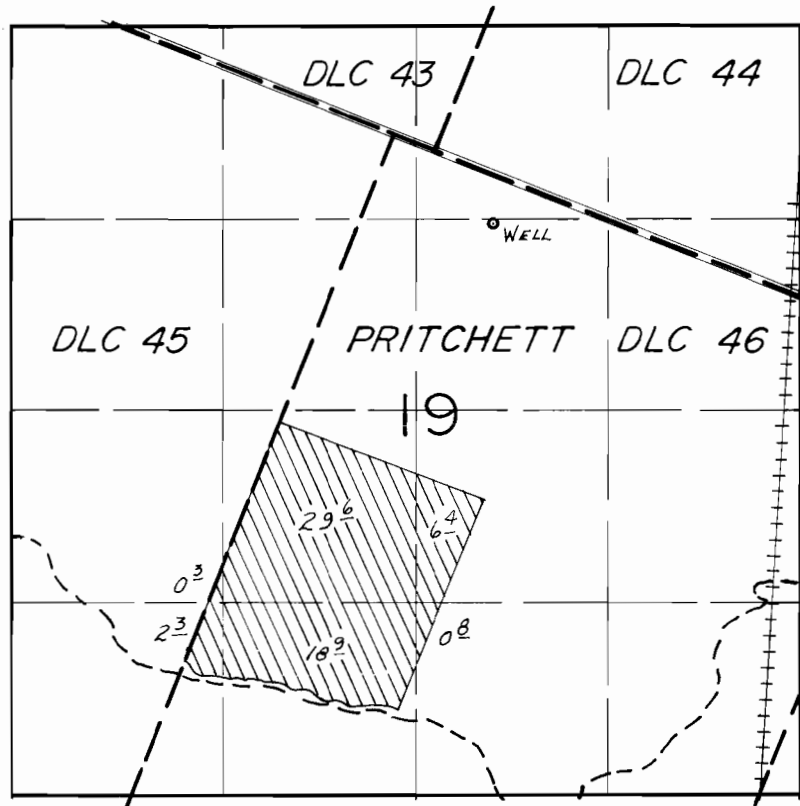

WELL LOC.: 600'S. & 680' E. FROM NW COR. PRITCHETT DLC 46.

SCALE: 1" = 1320'

FINAL PROOF SURVEY UNDER

Application No. G:11096. Permit No. G:10395...
IN NAME OF

..... ROGER DEJAGER

Surveyed May 15..... 19.85, by P.R. PAGTER.....