


T14S, R5W, WM

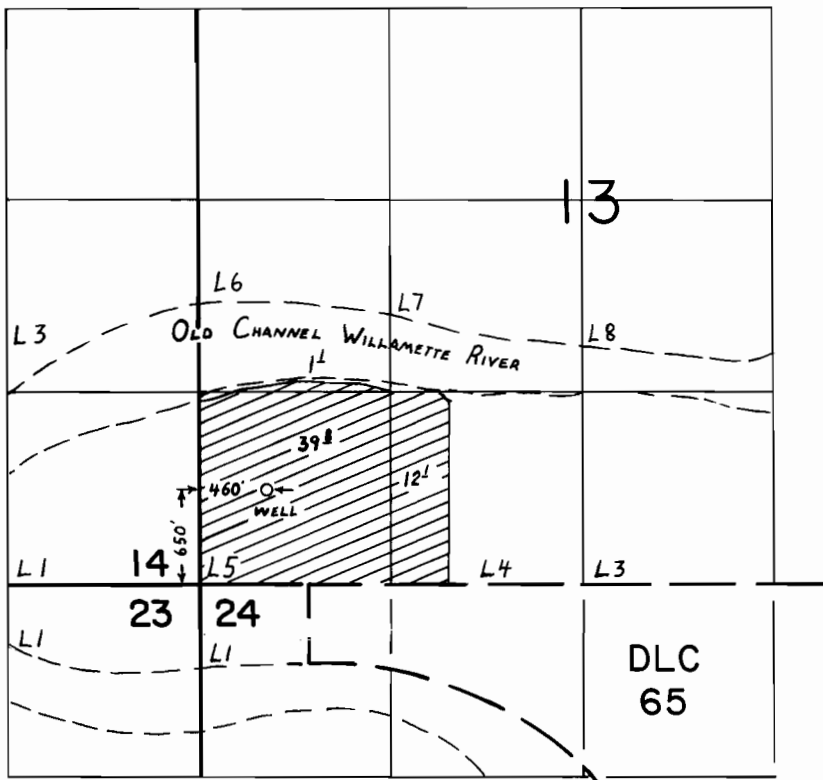

**FINAL PROOF SURVEY**  
 UNDER

Application No. G-11189. Permit No. G-10284.  
 IN NAME OF

.....DELBERT C. PITCHER.....

Surveyed AUG. 26. 1988, by T.M. WARREN...