


T.13S., R.16E., W.M.

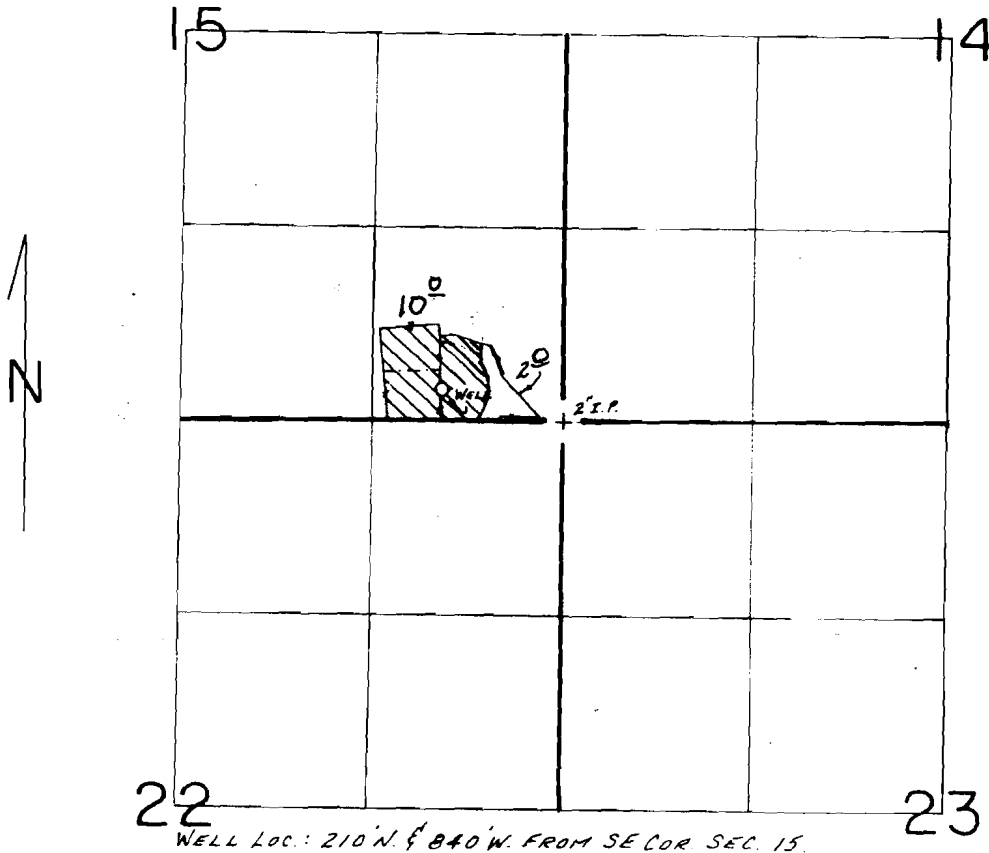

SCALE: 1"=1320'

FINAL PROOF SURVEY
UNDER

Application No. G-11277 Permit No. G-10409...
IN NAME OF

RUSSELL BOTTINI

Surveyed AUG. 25, 1987, by M.J. MATTICK...

Cert. #63616

RECEIVED

DATE

1-26-90

WATER MASTER DISTRICT #11

BY

DMJ

3/8/88 BWS
PTS 11-1987A

10409