


G-10444

1/4 CORNER  
S26 © S25

APPLETON ROAD

NW 1/4 SW 1/4  
SEC. 25

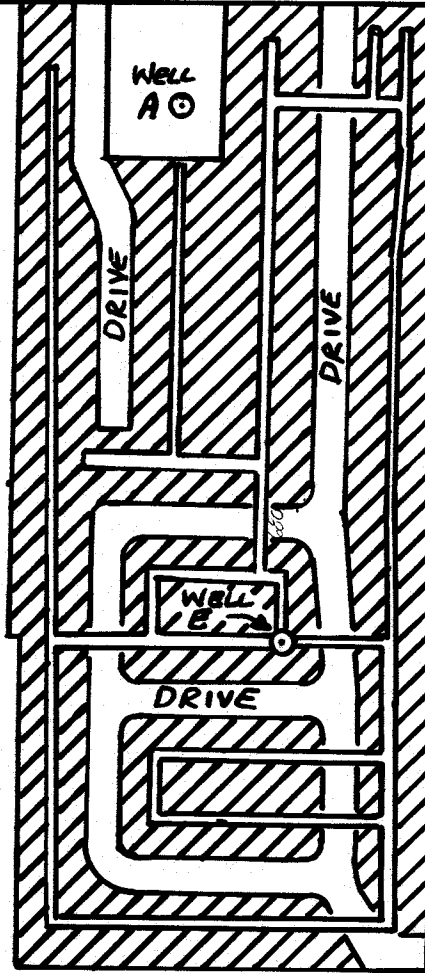

WELL C

NE  
SE

WELL D

STATE HIGHWAY No. 11

WELL "E" IS 654 FT. SOUTH & 921 FT. EAST  
OF THE 1/4 CORNER S26 / S25.

SW 1/4 SW 1/4  
SEC. 25

THIS MAP IS PREPARED  
PURPOSE TO SHOW  
AND USE. IT IS A  
OR LOCATE PROPE

G-10444  
63617

FINAL PROOF SURVEY  
&  
CLAIM OF BENEFICIAL USE  
TRANSFER NO. 6047  
HAROLD AKES  
NW 1/4 SW 1/4  
SEC. 25, T6N, R35E, W.M.

NE 1/4 SW 1/4  
SEC. 25

WELL D  
1132




LEGEND

- — = APPROXIMATE LOCATION OF 1/16<sup>TH</sup> LINES
- = WELL.
- ==== = APPROXIMATE LOCATION OF WATER LINES (BURIED).
- //// = AREA OF WATER USE FROM WELL "E". DOMESTIC, LAWN & GARDEN USE. GREEN ACRES MOBILE HOME PARK.

STATE HIGHWAY No. 11

MAP IS PREPARED FOR THE EXPRESS PURPOSE TO SHOW WATER APPROPRIATION USE. IT IS NOT INTENDED TO SHOW LOCATE PROPERTY OWNERSHIP LINES.

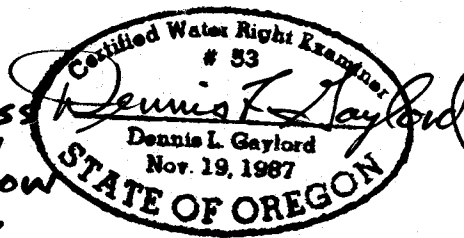

DENNIS L. GAYLORD  
4107 S.W. LAKE DRIVE  
PENDLETON, OR 97801  
503-276-6260