


# T 7 S, R 1 W, WM

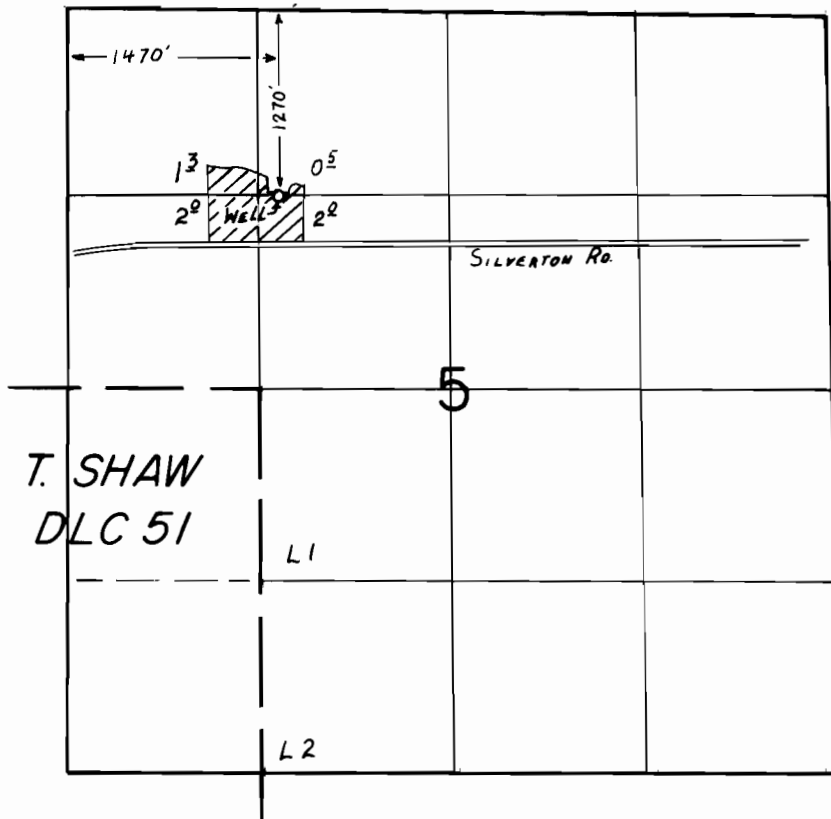

## FINAL PROOF SURVEY UNDER

Application No. G-11471 Permit No. G-10584.  
IN NAME OF

JERRY E. SCHURTER

Surveyed SEPT. 25, 1986., by T.M. WARREN...