


T.15S., R. 43E., W.M.

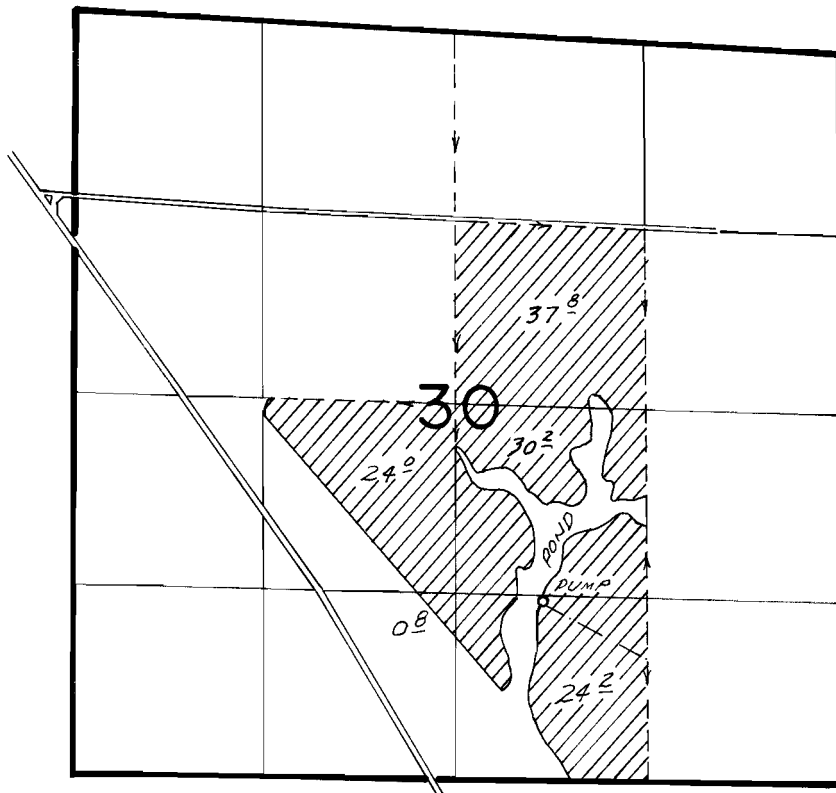

FINAL PROOF SURVEY
UNDER

Application No. 25460. Permit No. 21494.....
IN NAME OF

.....ORCHARDS WATER COMPANY.....

Surveyed FEB. 12, 1980, by F.W. ELFERING.

*Supervisor
5/89*

11-29-83
P.T.S

BWB