
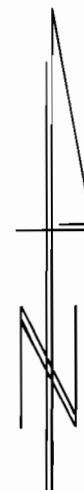


T2N, R2W, WM

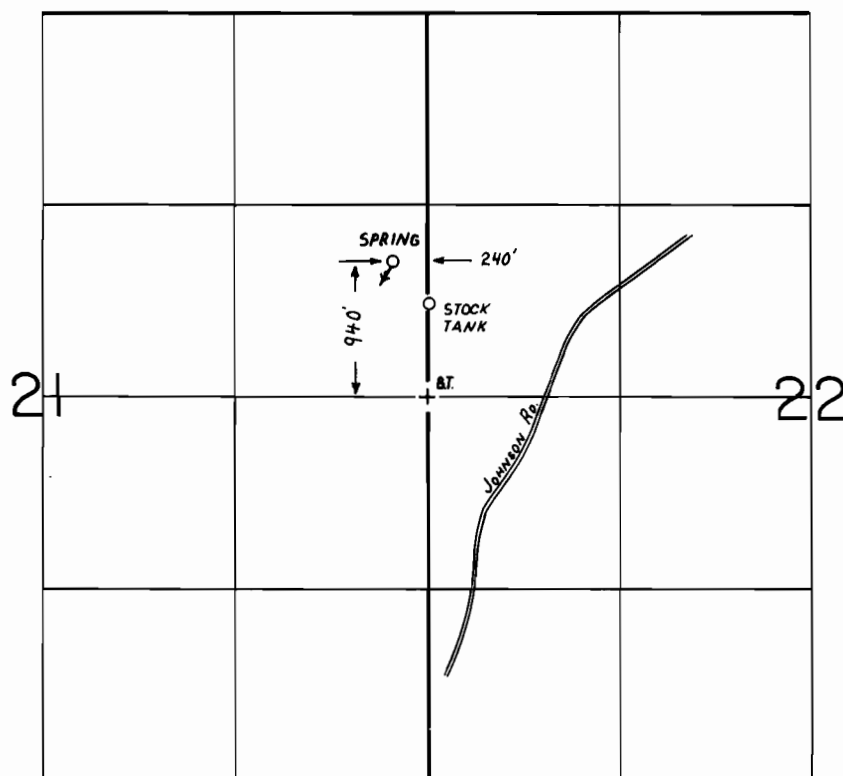

SCALE
1" = 1320'

FINAL PROOF SURVEY UNDER

Application No. 52006.. Permit No. 39203.....
IN NAME OF

R...BRUCE... & ...RENA...C...SNYDER...

Surveyed MAR...29. 1988., by T.M...WARREN....