




T. 6 S., R. 8 W., W.M.

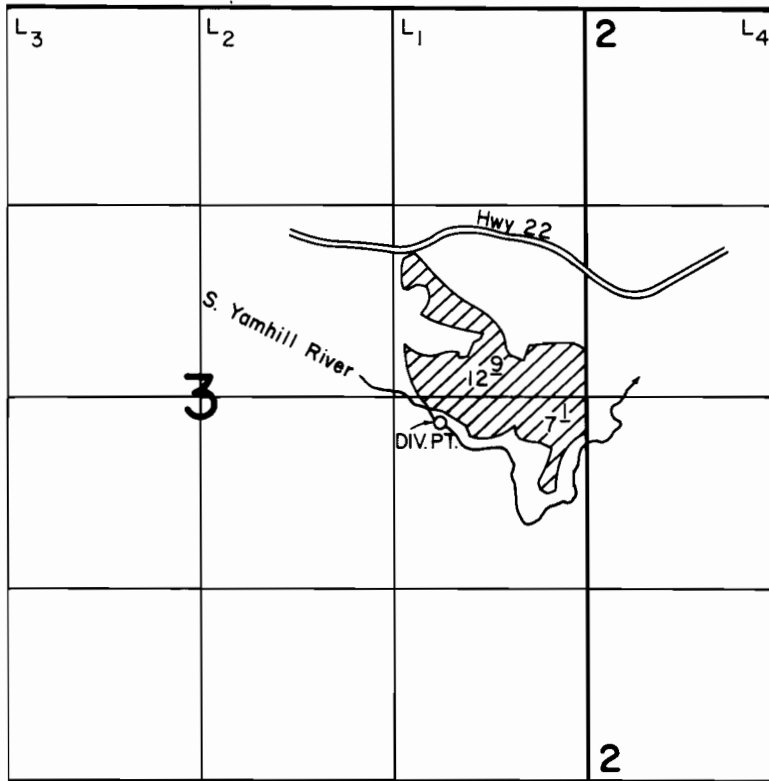

DIV. PT. LOC.: 190' S. & 1000' W. FROM E. 1/4 CORNER SECTION 3

SCALE: 1" = 1320'

FINAL PROOF SURVEY UNDER

Application No. 52999 Permit No. 40006
IN NAME OF

ISAAC M. RISSEEUW

Surveyed MAY 8 1989, by T. M. WARREN