


T. 2S., R. 3W., W. M.

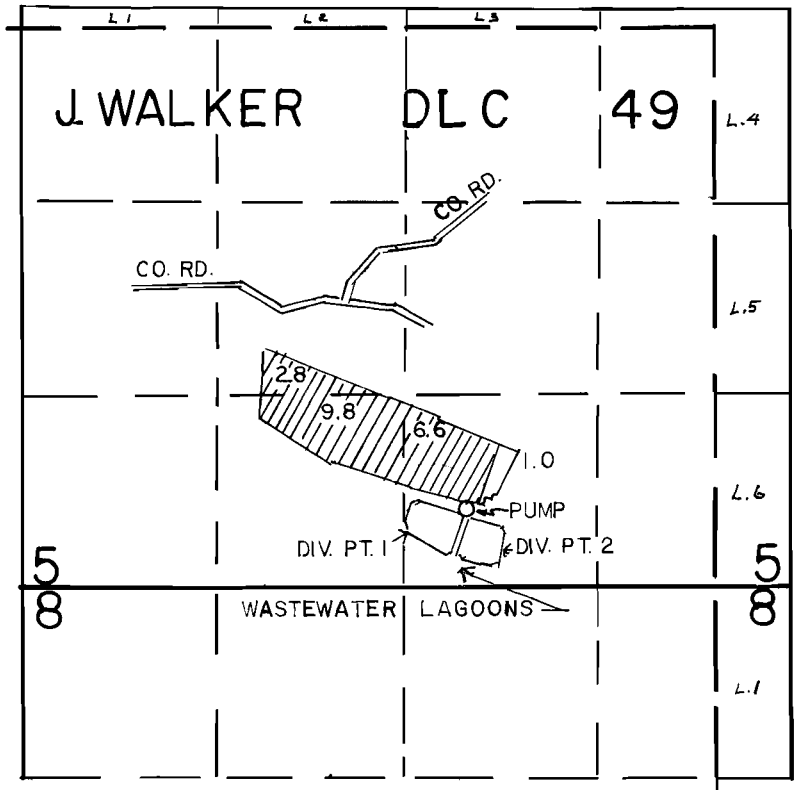

*Div. Pt. Located: 550 feet N. & 450 feet E. from 3/4 Corner Section 5.*

SCALE: 4" = 1 MILE

*550' N  
450' E*

### FINAL PROOF SURVEY UNDER

R-55228      R- 6574

Application No. ~~55229~~ Permit No. ~~41526~~

IN NAME OF

WESTERN OREGON CONFERENCE ASSOCIATION  
OF SEVENTH-DAY ADVENTISTS  
Surveyed NOV 14 1983 by L. TOLL