


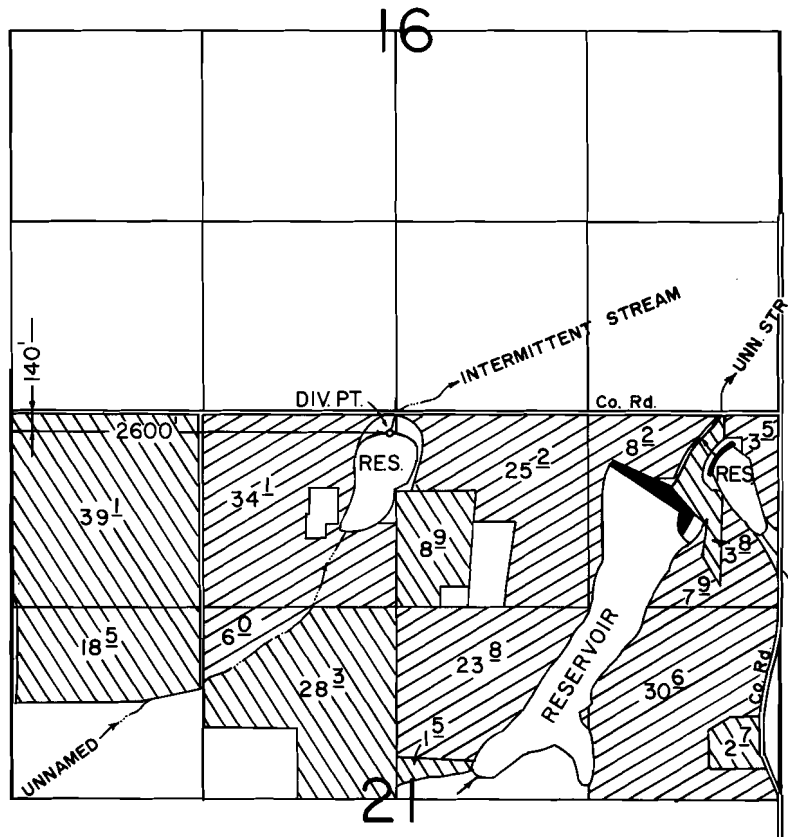



T. 1 S., R. 3 W., W.M.



SCALE: 1" = 1320'

FINAL PROOF SURVEY UNDER

-  PRIMARY
-  SUPPLEMENTAL

R-55329 R-6580

Application No. 55330. Permit No. 41549.....

IN NAME OF

OREGON GARDEN PRODUCTS, INC.

Surveyed AUG. 13... 1986, by B.W. BISHOP.....