




T. 32 S., R. 15 W., W.M.

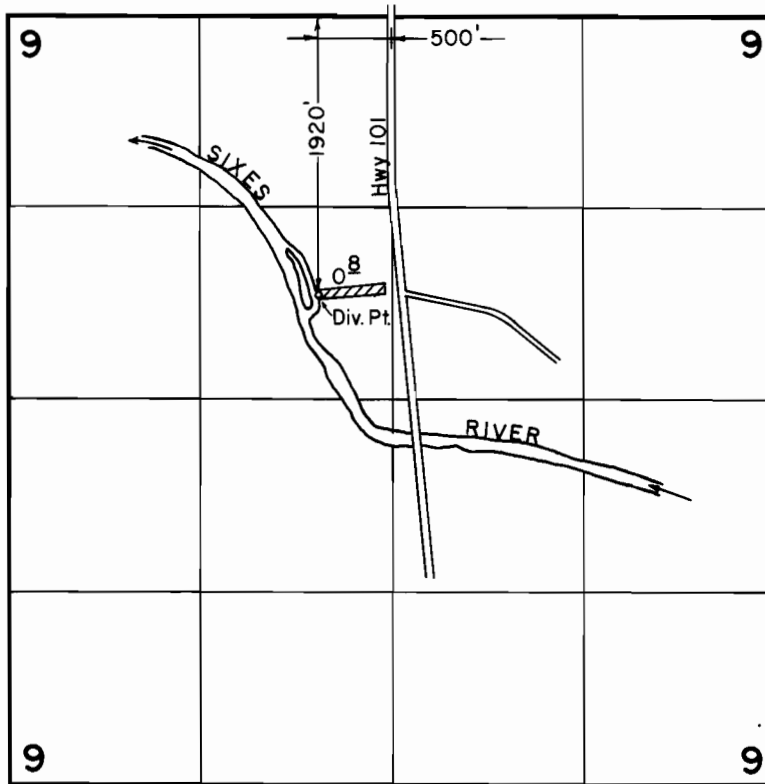

SCALE: 1" = 1320'

FINAL PROOF SURVEY
UNDER

Application No. 56680 Permit No. 42078
IN NAME OF

CHARLES E. & MICKI G. MARKS

Surveyed JUNE 28 1988, by B. S. JAMES