


T.5S., R.6W. W.M.

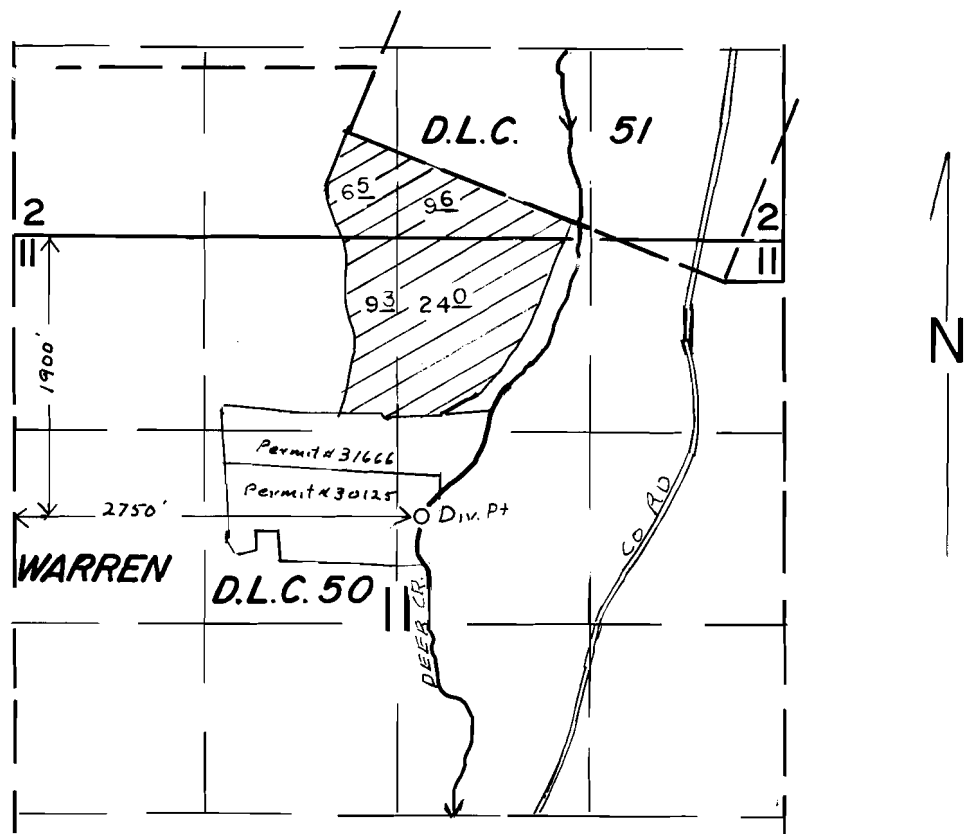

SCALE: 1"=1320'

**FINAL PROOF SURVEY**  
UNDER

Application No. 56982 Permit No. 42774.....  
IN NAME OF

EDWIN NOAH TATE.....

Surveyed JULY 7.... 1987., by B.W. BISHOP.....