


T. 20S., R. 39E., W.M.

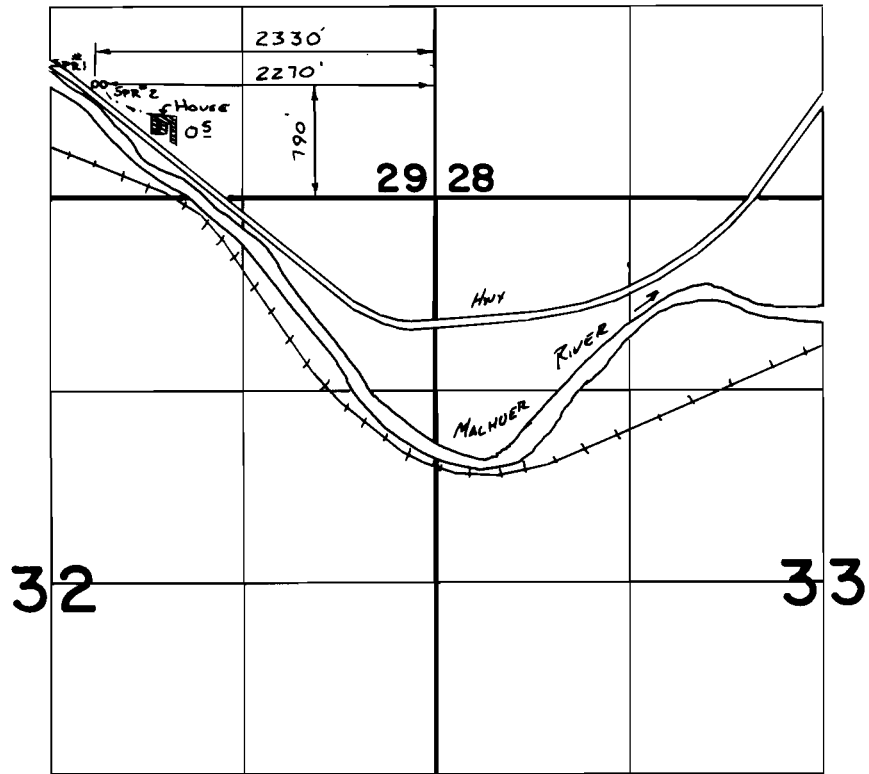

SCALE 1"=1320'

FINAL PROOF SURVEY UNDER

Application No. **58222** Permit No. **43938**...
IN NAME OF

.....**DARRYL**.....**WILLIAMS**.....

Surveyed *5-24*..... 19*88*, by *V.L. Church*.....