


# T4S, R12&13E, WM

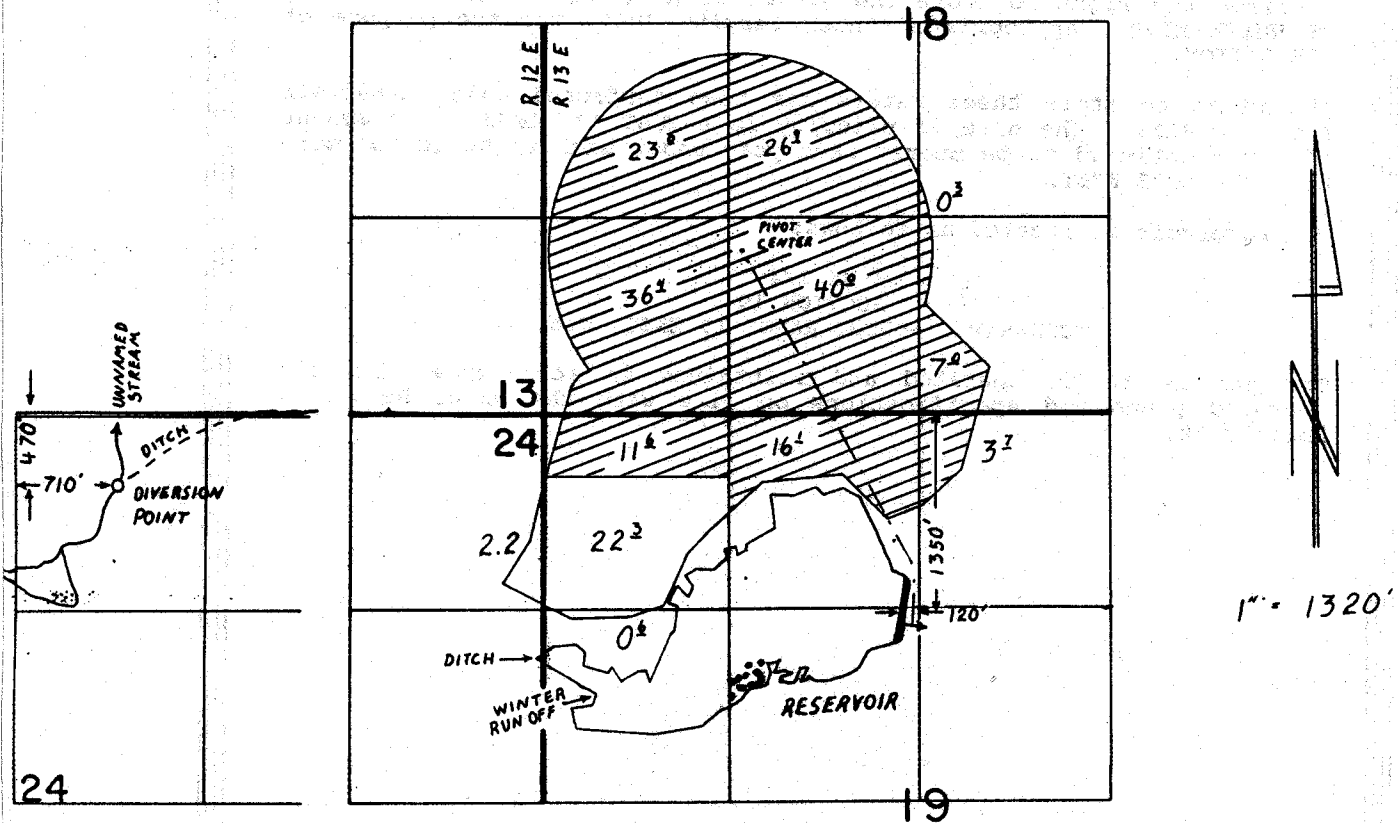

## FINAL PROOF SURVEY

UNDER

R-59259      R-8139  
 59260      44901  
 63228      47033

Application No. R-64058 Permit No. R-8502.....

IN NAME OF

..... CRAIG A. SNYDER .....

Surveyed JUNE 25, 1987., by T. M. WARREN..

RWK  
 PTS 1987A  
 41065 472 67