


T4S, R12&13E, WM

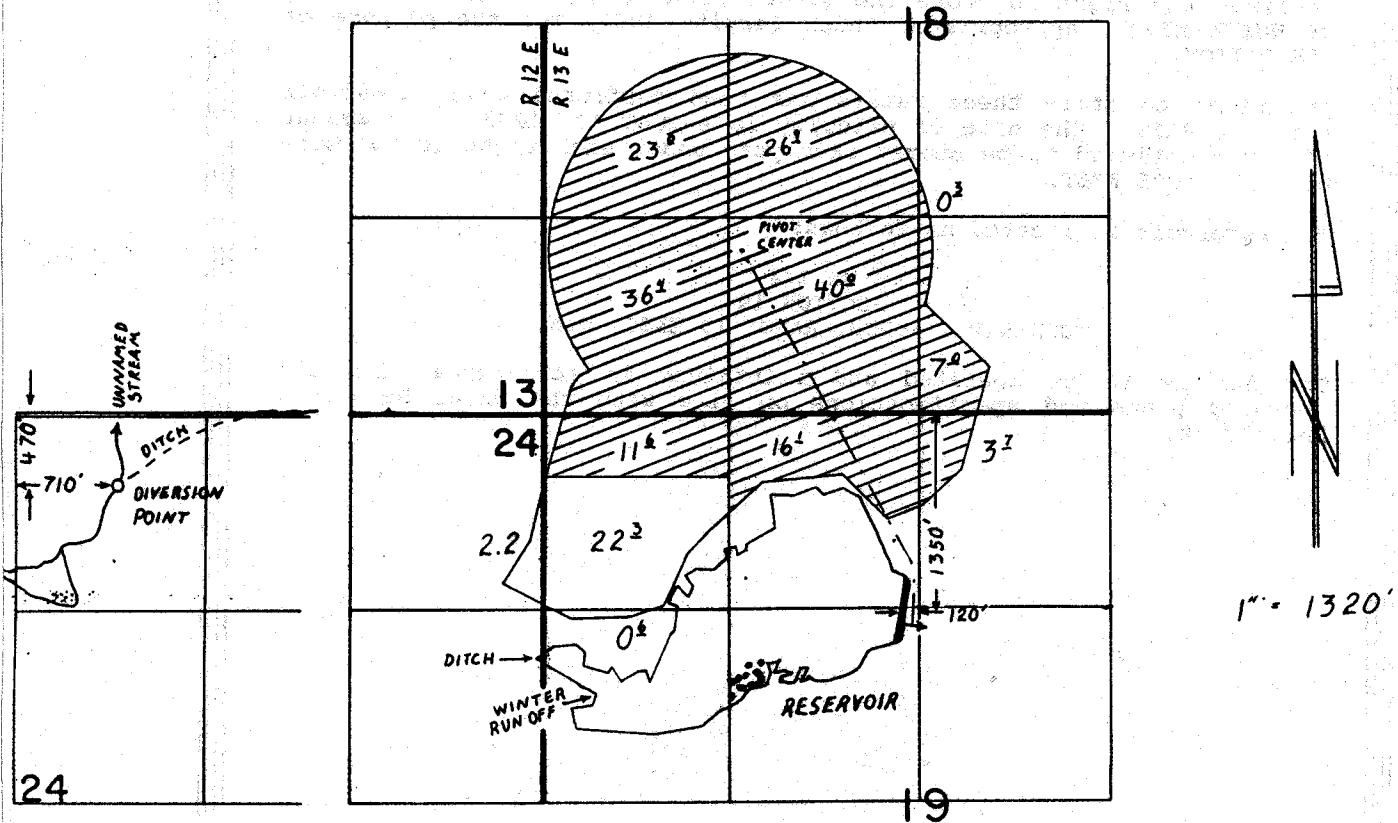

FINAL PROOF SURVEY

UNDER

R-59259

R-8139

59260

44901

63228

47033

Application No. R-64058 Permit No. R-8502.....

IN NAME OF

CRAIG A. SNYDER.....

Surveyed JUNE 25, 1987., by T. M. WARREN..

RWK
PTS 1987A
41065 472 67