


T4S, R12&13E, WM

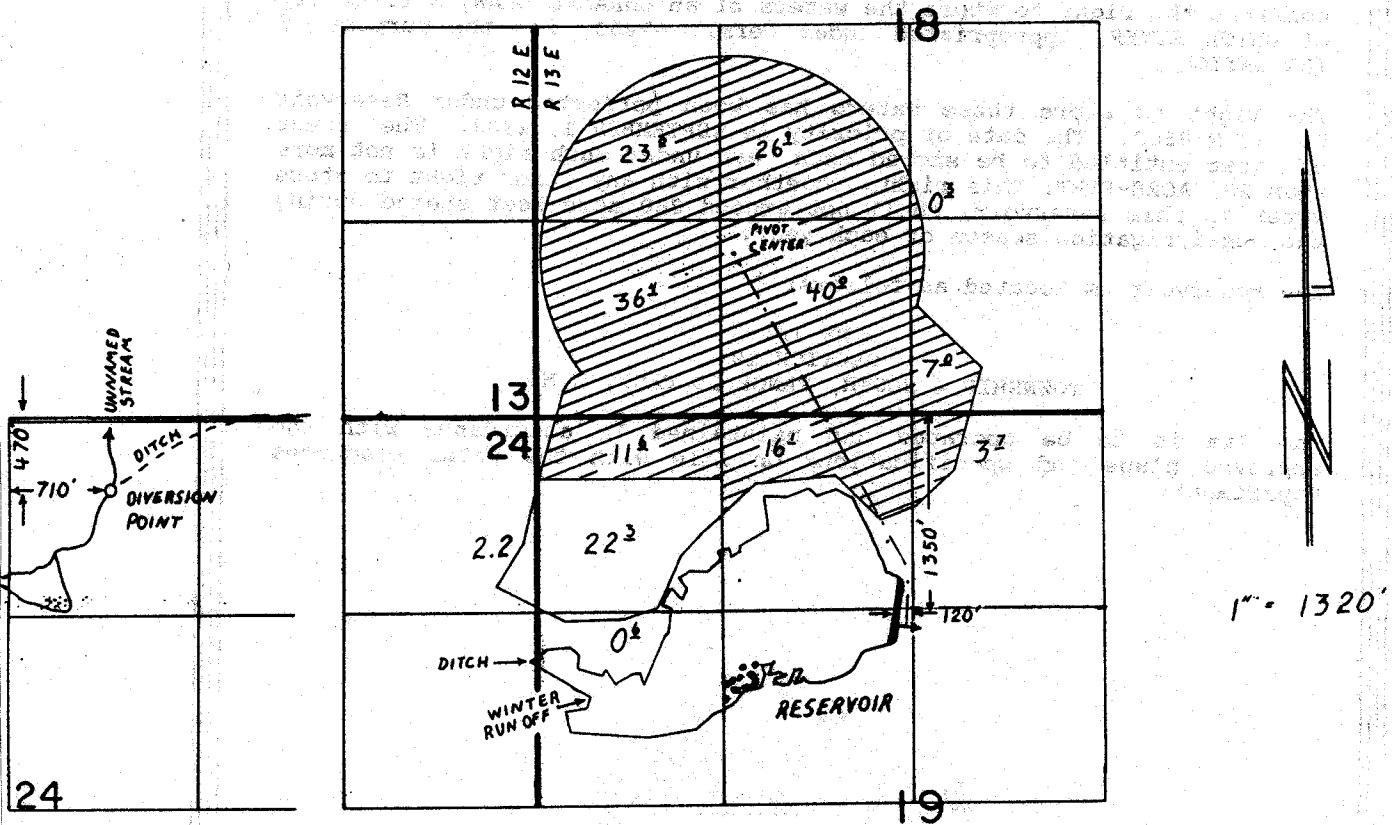

FINAL PROOF SURVEY

UNDER

R-59259 R-8139
 59260 44901
 63228 47033
 Application No. R-64058 Permit No. R-8502.....

IN NAME OF

CRAIG A. SNYDER.....

Surveyed JUNE 25, 1987., by T. M. WARREN..

RWK
 PTS 1987A
 41065 472 67