


T.5S., R.6W., W.M.

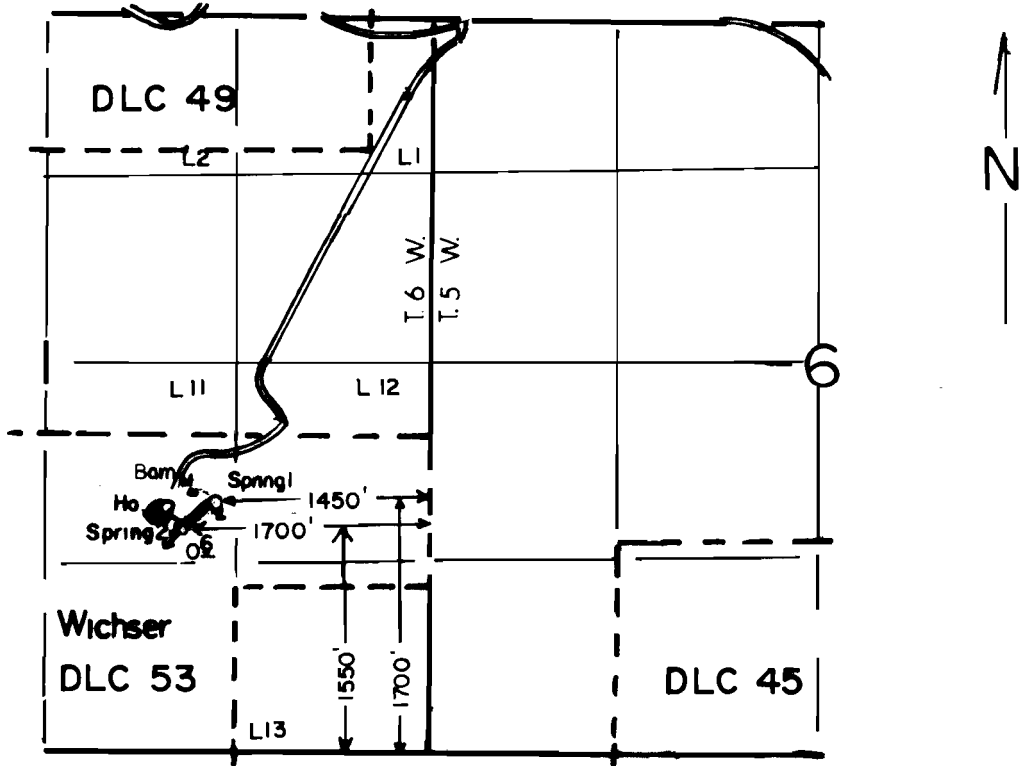

SCALE: 1" = 1320'

**FINAL PROOF SURVEY**  
UNDER

Application No. 59423 Permit No. 44804  
IN NAME OF

PRENTIS C. & SHARON W. HALE

Surveyed MAY 12, 1989, by I.M. WARREN