


TIIS, RIOW, WM

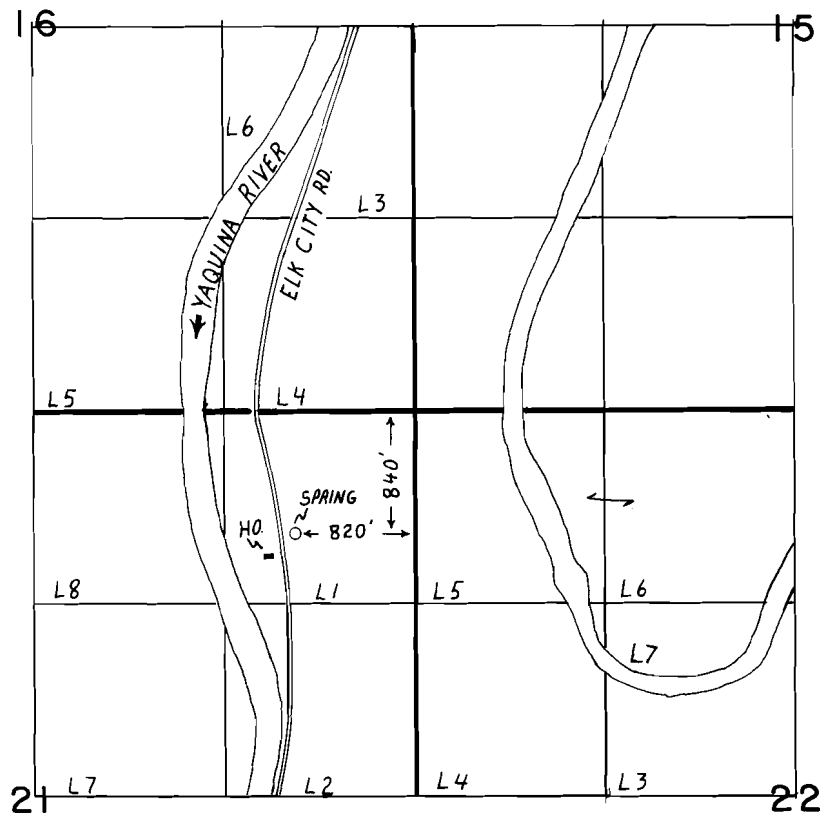

FINAL PROOF SURVEY UNDER

Application No. 6.Q.Q.6.7 Permit No. 4.5.Q.8.Q....
IN NAME OF

HAROLD E. & MARY L. BRANDT

Surveyed MAY 23, 1988, by T. M. WARREN.