


T. 23S., R. 26E., W.M.

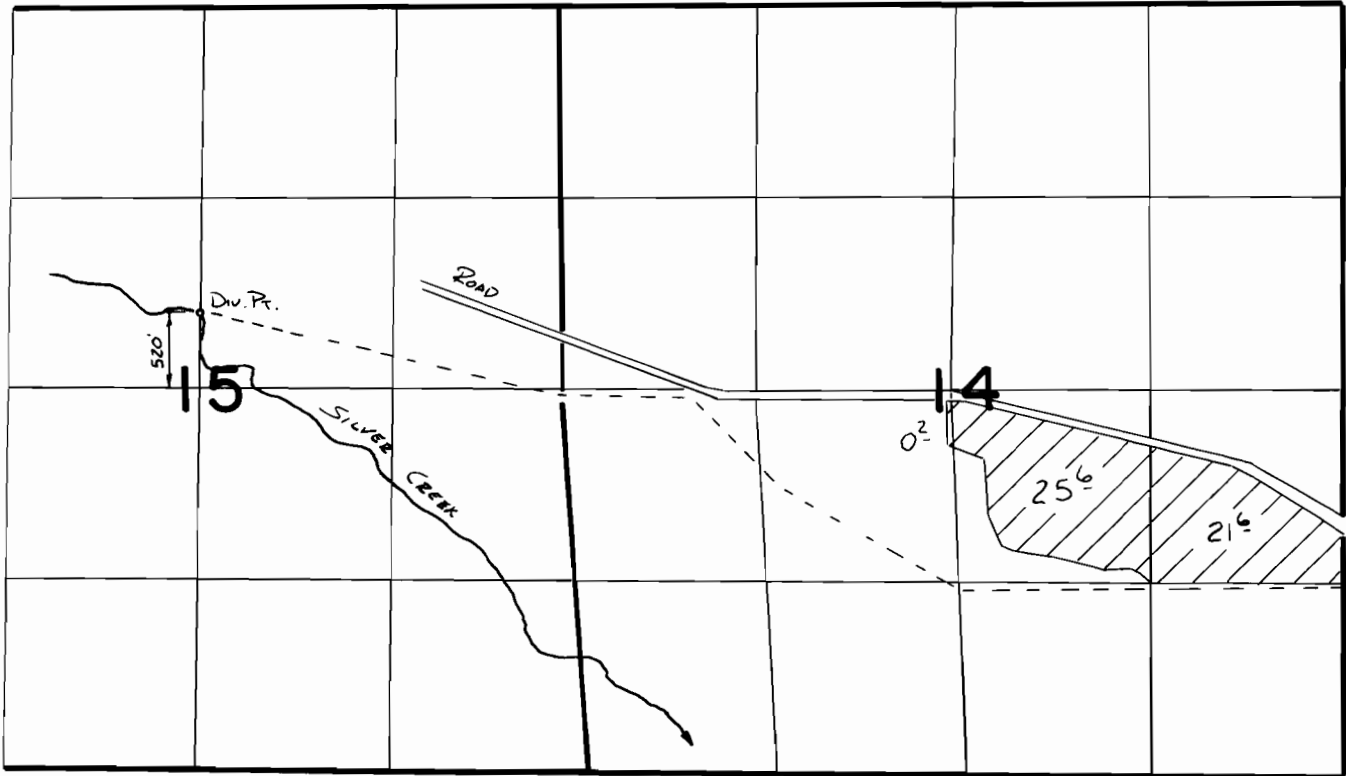

SCALE 1" = 1320'

FINAL PROOF SURVEY
UNDER

Application No. **60306** Permit No. **46287**....
IN NAME OF

.....**RAY AKERMAN**.....

Surveyed ..5-6..... 1988, by *R.W. Bishop*.....