


T.7S., R.48E., W.M.

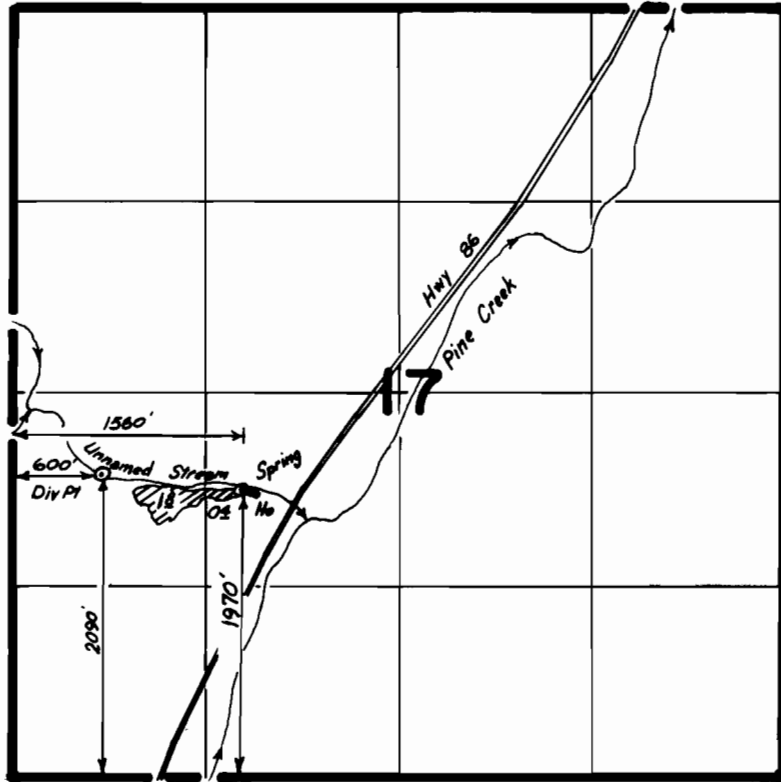

Scale: 1" = 1320'

FINAL PROOF SURVEY UNDER

Application No. **60503** Permit No. **45299**.....
IN NAME OF

.....**VIOLET**.....**COLE**.....

Surveyed**10-3**.... **1988**., by ..**Kern Kemp**.....