
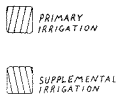


PH 45361

TIN, R14E, WM

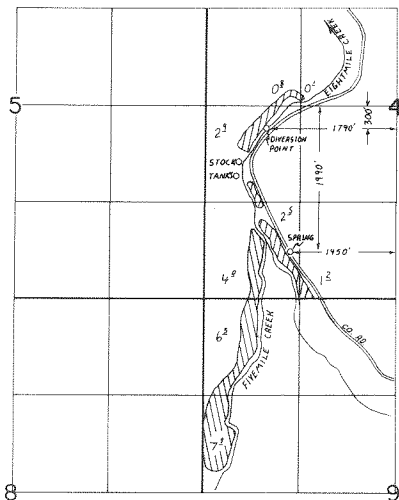

FINAL PROOF SURVEY UNDER

Application No. 60727. Permit No. 45361.....
IN NAME OF

.....JOHN & RUTH FULTON.....

Surveyed JUNE 8, 1988, by T.M. WARREN..

RWK
4065 179 1248