


T. 2 S, R. 5 W, W.M.

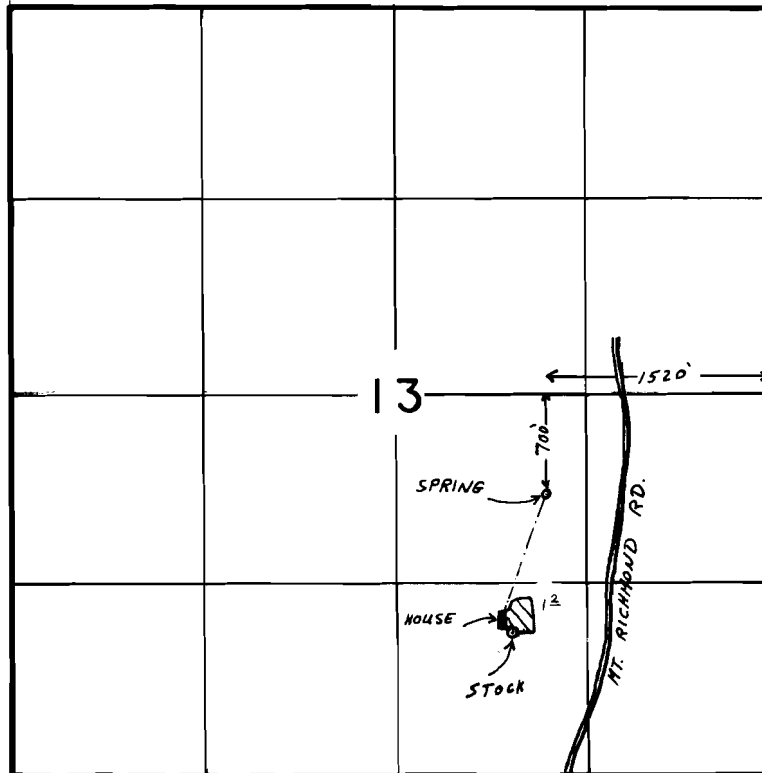

SCALE 1" = 1320'

FINAL PROOF SURVEY
UNDER

Application No. 60858 Permit No. 46231
IN NAME OF

DONNA & JOE BRADLEY

Surveyed OCT. 25, 88, by Z. SALEH