


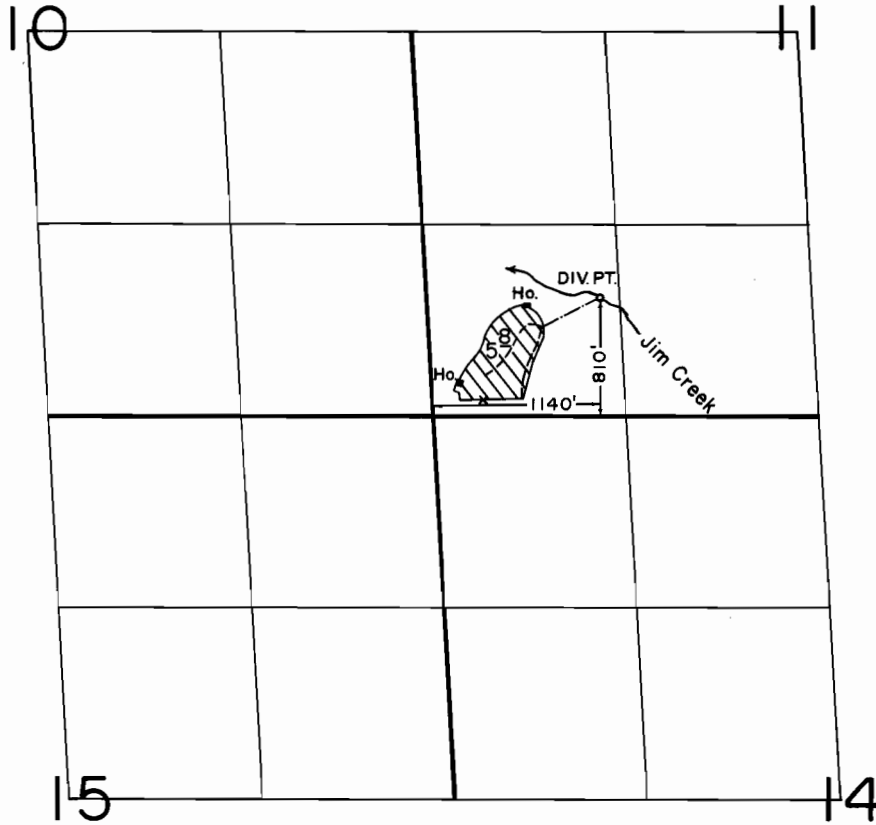

T. 31 S., R. 15 W., W.M.



SCALE: 1" = 1320'

**FINAL PROOF SURVEY**  
UNDER

Application No. 61342.. Permit No. 46235....  
IN NAME OF

DAVID JOHN STOUT, SR.

Surveyed JUNE 25 1988, by L. M. JOACHIMS