


T. 26 S., R. 6 AND 7 W., W. M.

SECTIONS 19, 24, 25 AND 30

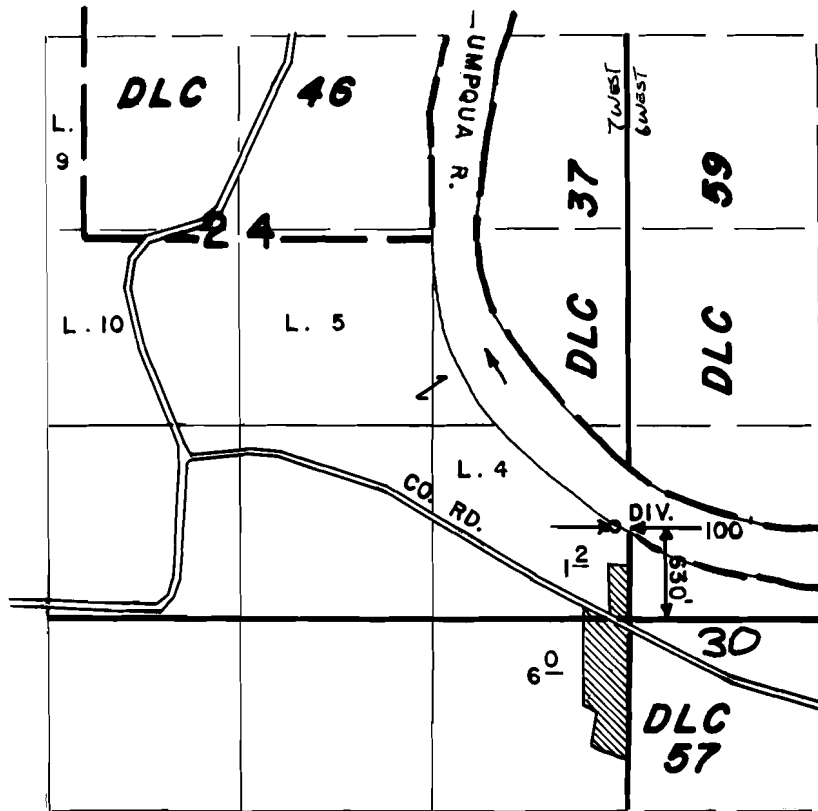

SCALE 4" = 1 MILE

FINAL PROOF SURVEY UNDER

Application No. 61420... Permit No. 45660.....
IN NAME OF

ROBERT R. MUELLER

Surveyed MAY 17... 1988, by J.M. SCHMORDE