


T. 4 S., R. 5 W., W.M.

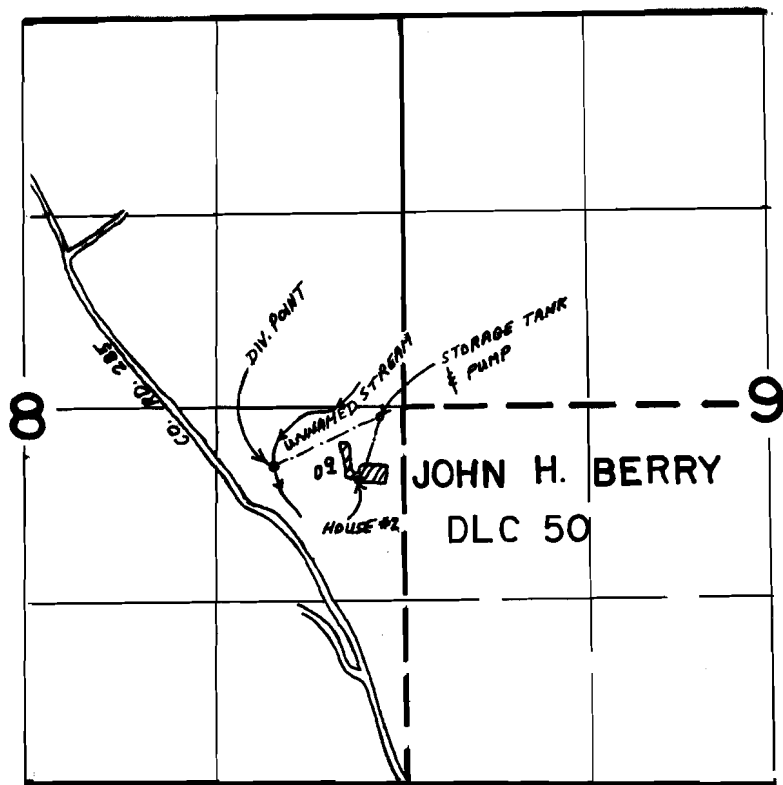

DIV. POINT : 400' S, & 900' W FROM THE EAST 1/4 CORNER SEC. 8

SCALE 1" = 1320'

FINAL PROOF SURVEY

UNDER

Application No. 61592 Permit No. 46051
IN NAME OF

DAVID A. STEFAN

Surveyed OCT. 4 1988 by Z. SALEH