




T. 32 S., R. 15 W., W.M.

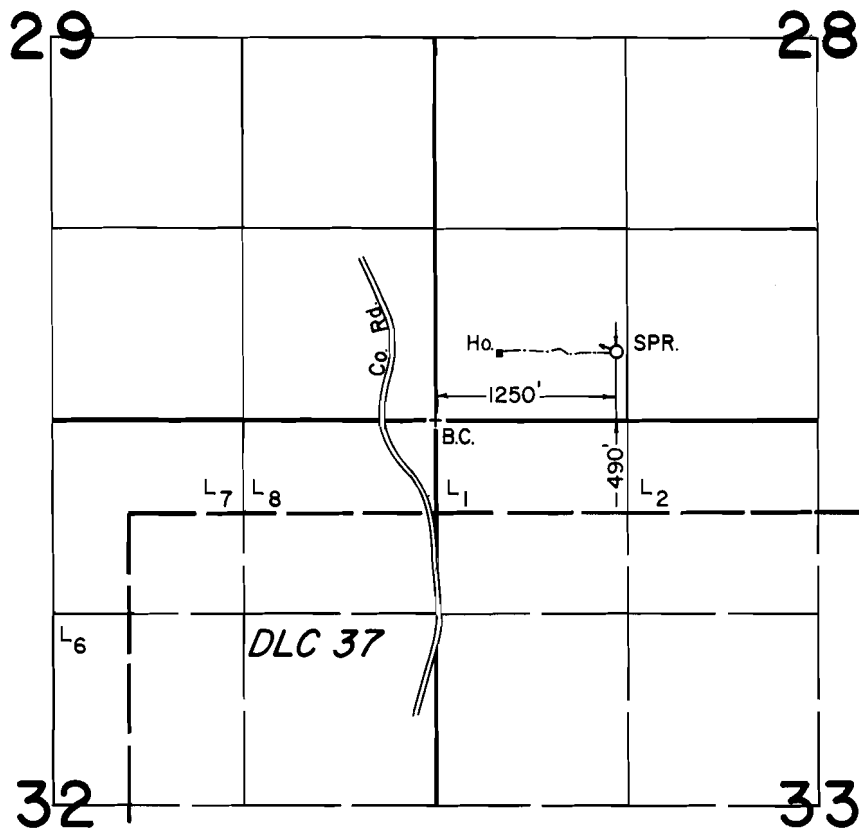

SCALE: 1" = 1320'

FINAL PROOF SURVEY
UNDER

Application No. 61743... Permit No. 46132.....

IN NAME OF

LOUIS & MARGARET DALTON

Surveyed JUNE 25 1989., by B. S. JAMES.....