


T. 26 S., R. 7 W., W. M.

SECTION 26

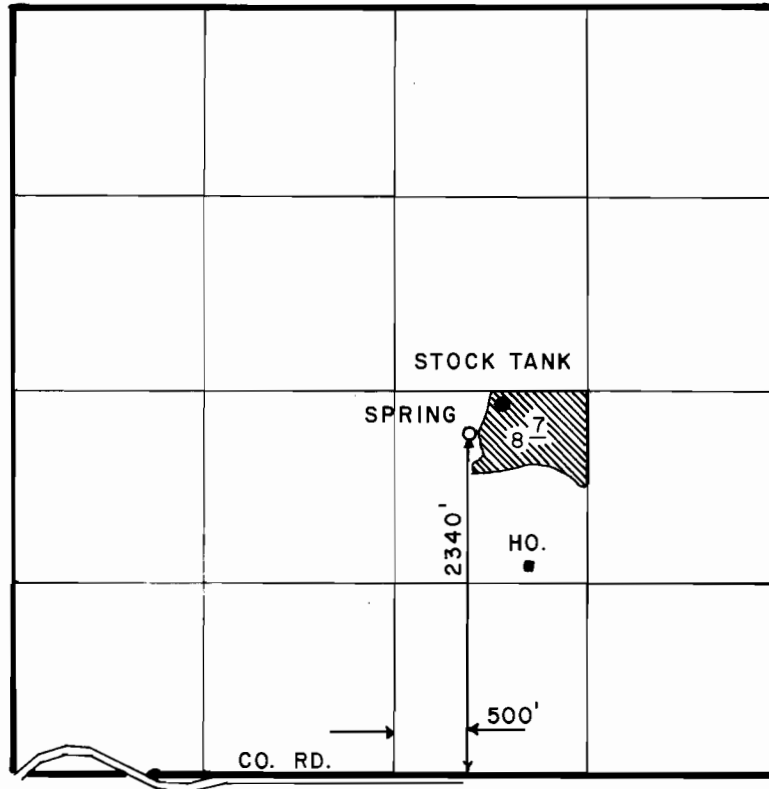

SCALE: 4" = 1 MILE

FINAL PROOF SURVEY UNDER

Application No. 61808... Permit No. 46095.....
IN NAME OF

ARTHUR J. ATCHISON

Surveyed JUNE 27, 1988, by J. M. SCHMORDE