


T.13S., R.11W., W.M.

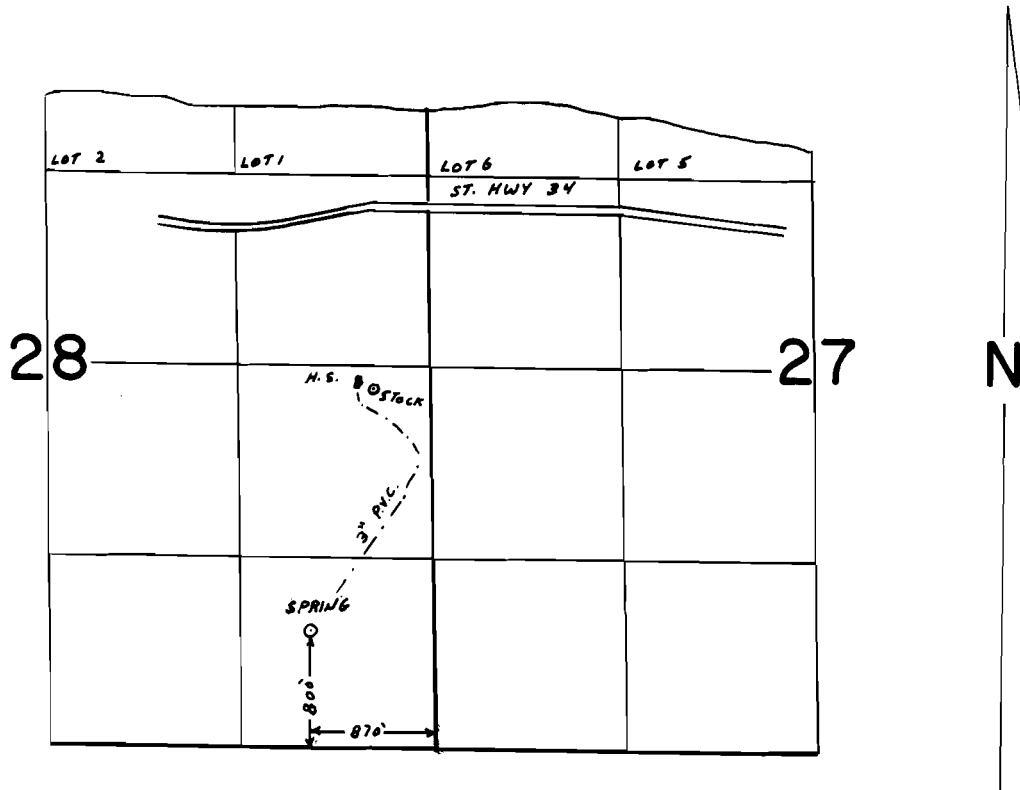

SCALE 1" = 1320'

FINAL PROOF SURVEY UNDER

62917

46606

Application No. 61964 Permit No. 45972

IN NAME OF

ARTHUR R. PETERSON

Surveyed JUL 28 1988 by Z. SALEH