


T. 37 S., R. 8 W., W. M.

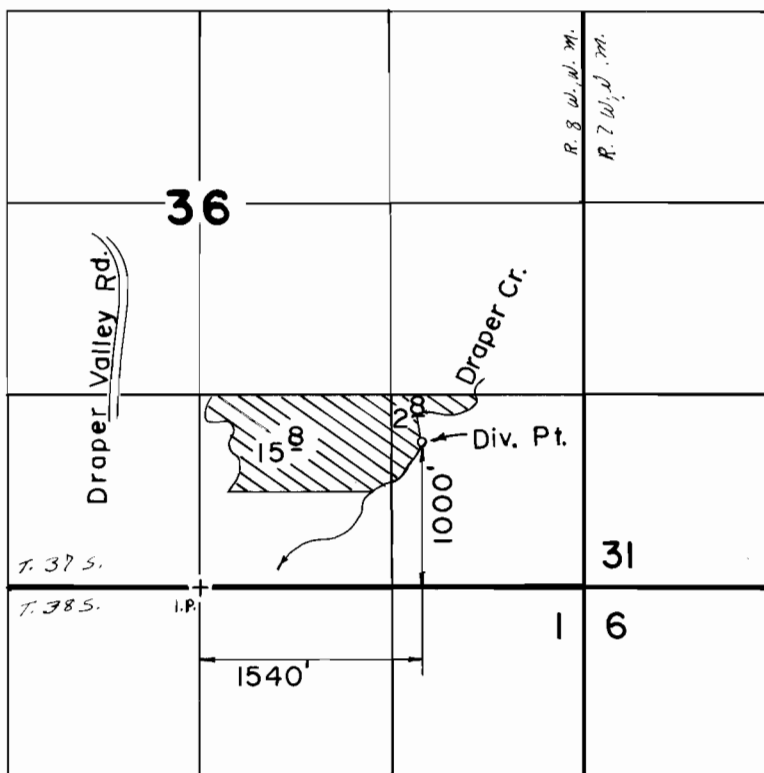

Scale: 1" = 1320'

# FINAL PROOF SURVEY UNDER

Application No. 62818 Permit No. 47299  
IN NAME OF

RALPH L. & IRENE SELTZER

Surveyed NOV. 18, 1987, by B. S. JAMES.