


# T19S. R11W. WM.

Application No. 62834  
Permit No. 46764

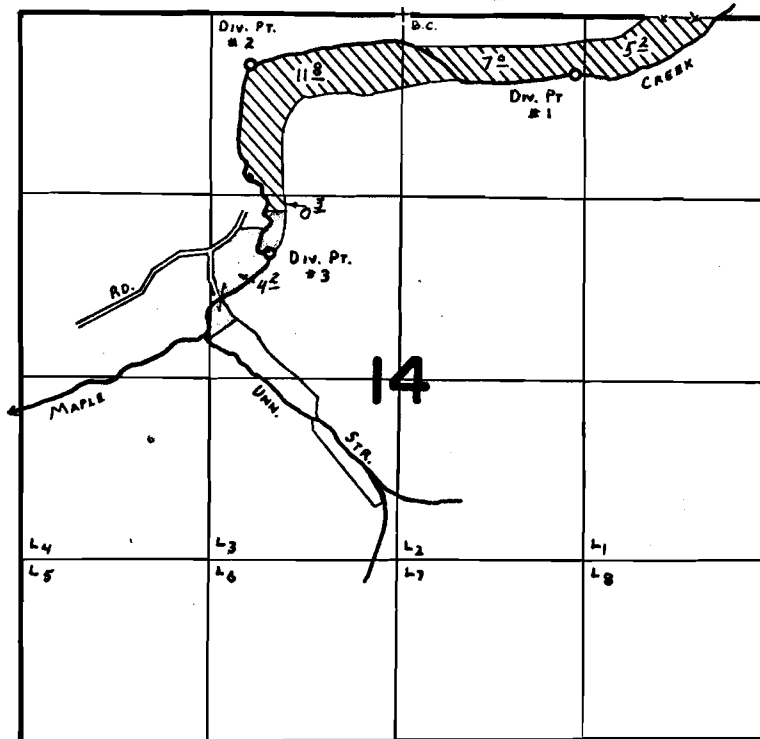

Div. Pts. Loc: }  
#1- 400'S. & 1190'E. }  
#2- 360'S. & 1040'W. } ALL FROM N. 1/4 COR. SEC. 14.  
#3- 1650'S. & 900'W. }

~~FINAL PROOF SURVEY~~  
UNDER

~~Application No. 42364 Permit No. 31938~~

IN NAME OF  
GORDON W. & DONNA B. JOHNSON  
WILLIAM F. & MARJORIE M. HILL

Surveyed JULY 26 1978, by C. L. HUGHES.