


T.3S, R.5&6W, W.M.

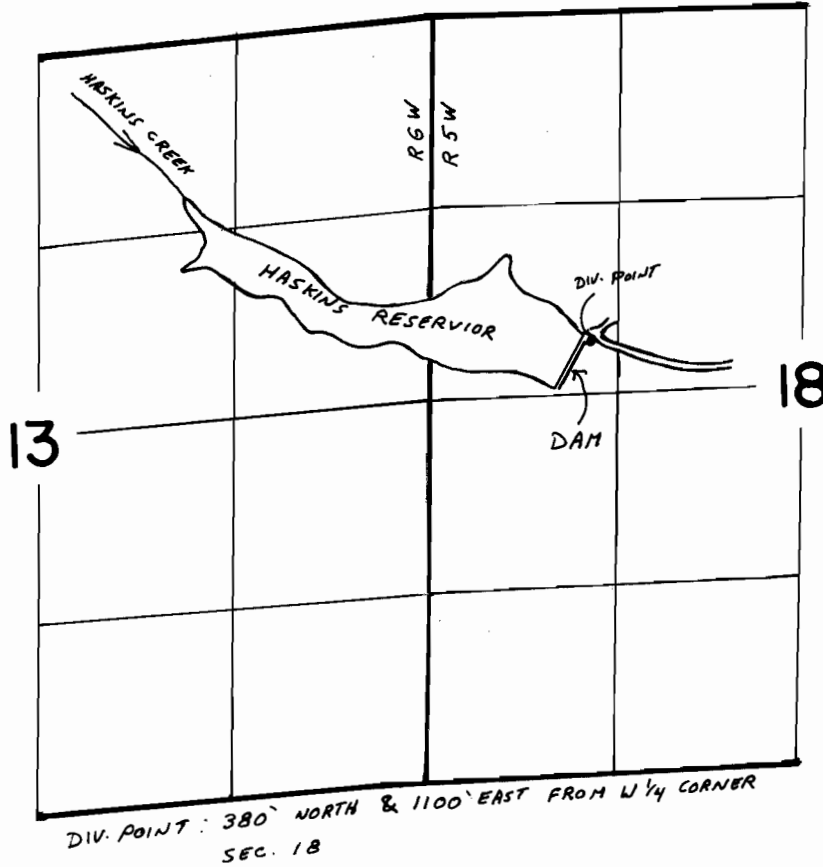

SCALE 1" = 1320'

FINAL PROOF SURVEY
UNDER

Application No. R-63054 Permit No. R-8885
IN NAME OF

CITY OF MCMINVILLE

Surveyed OCT. 14 1988, by Z. SALEH