


T.15S., R.14E., W.M.

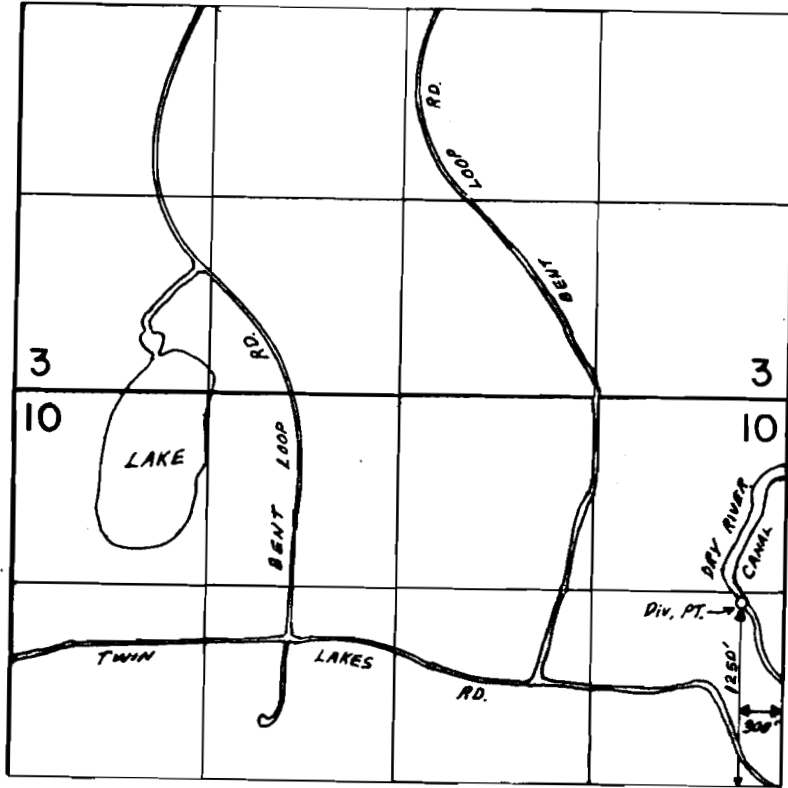

SCALE: 1"=1320'

FINAL PROOF SURVEY
UNDER

Application No. 63107... Permit No. 46930...
IN NAME OF

TWIN LAKES RANCH, et. al.

Surveyed JUN. 1 1988, by B. BISHOP

Cert. # 63661

RECEIVED

DATE 1-26-90

WATER MASTER DISTRICT #11

MB