


T.6N, R.6 W, WM

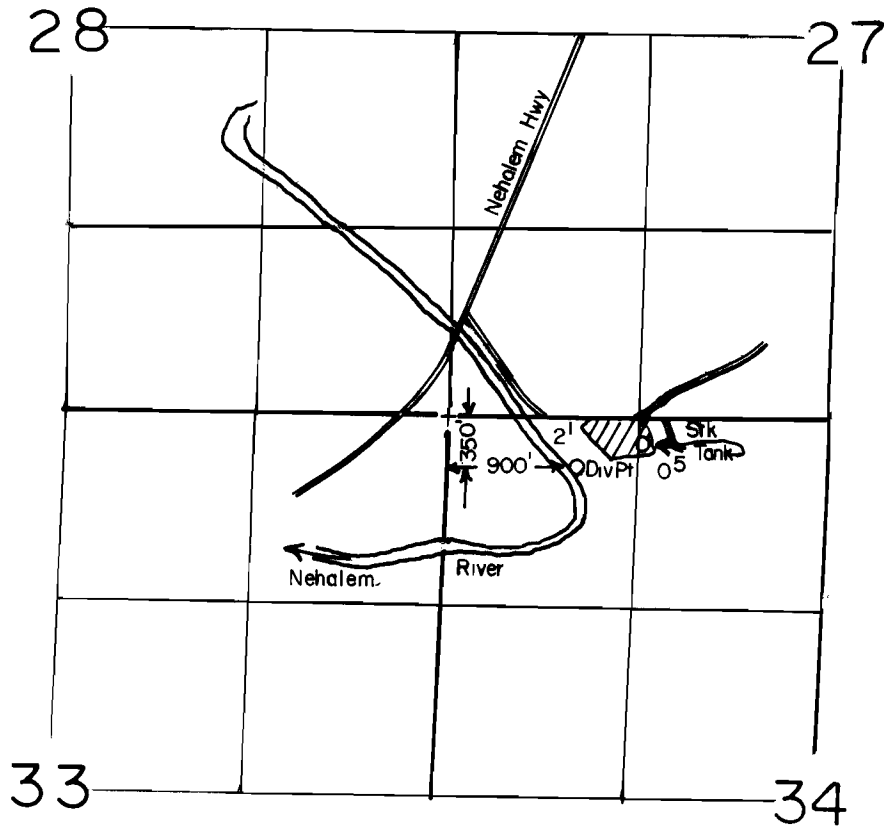

SCALE: 1" = 1320'

**FINAL PROOF SURVEY  
UNDER**

Application No. 63115..... Permit No. 46316.....  
IN NAME OF

.....LADDIE.....POLANEK.....

Surveyed JUNE 20, 1989, by T.M. WARREN.....