N

T.5 & 6 S., R.6 & 7 W., W.M.

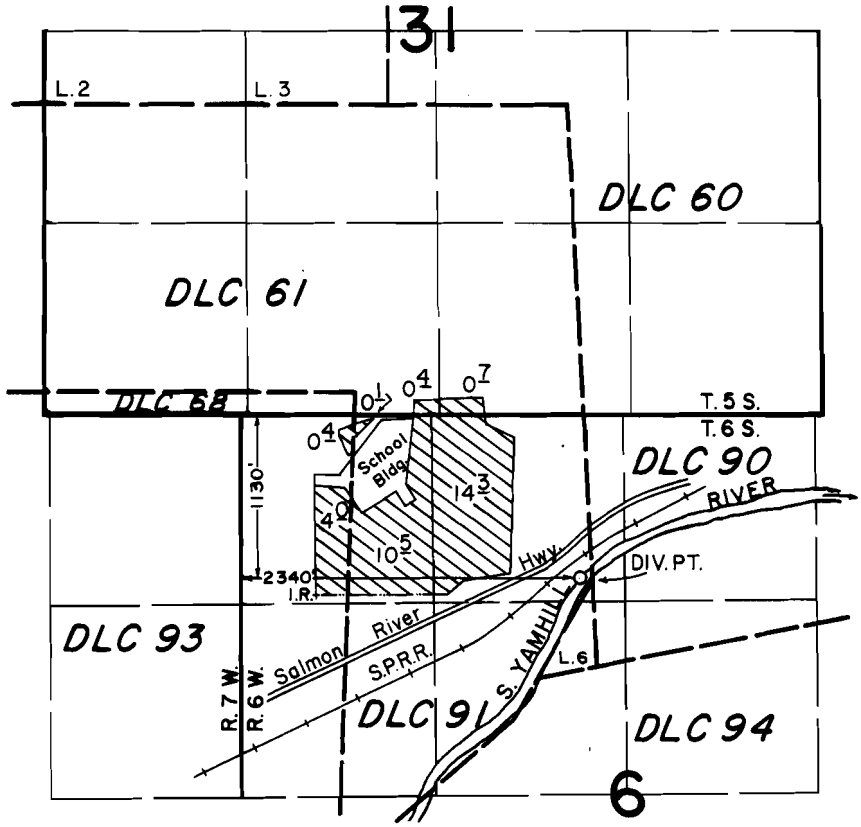

SCALE: 1" = 1320'

FINAL PROOF SURVEY

UNDER

Application No. 63327 Permit No. 46422

IN NAME OF

WILLAMINA SCHOOL DISTRICT 30-J

Surveyed JUNE 1 1989, by T. M. WARREN

9-7-89
41071-178-02R
PTS