


T. 32 S., R. 4 W., W.M.

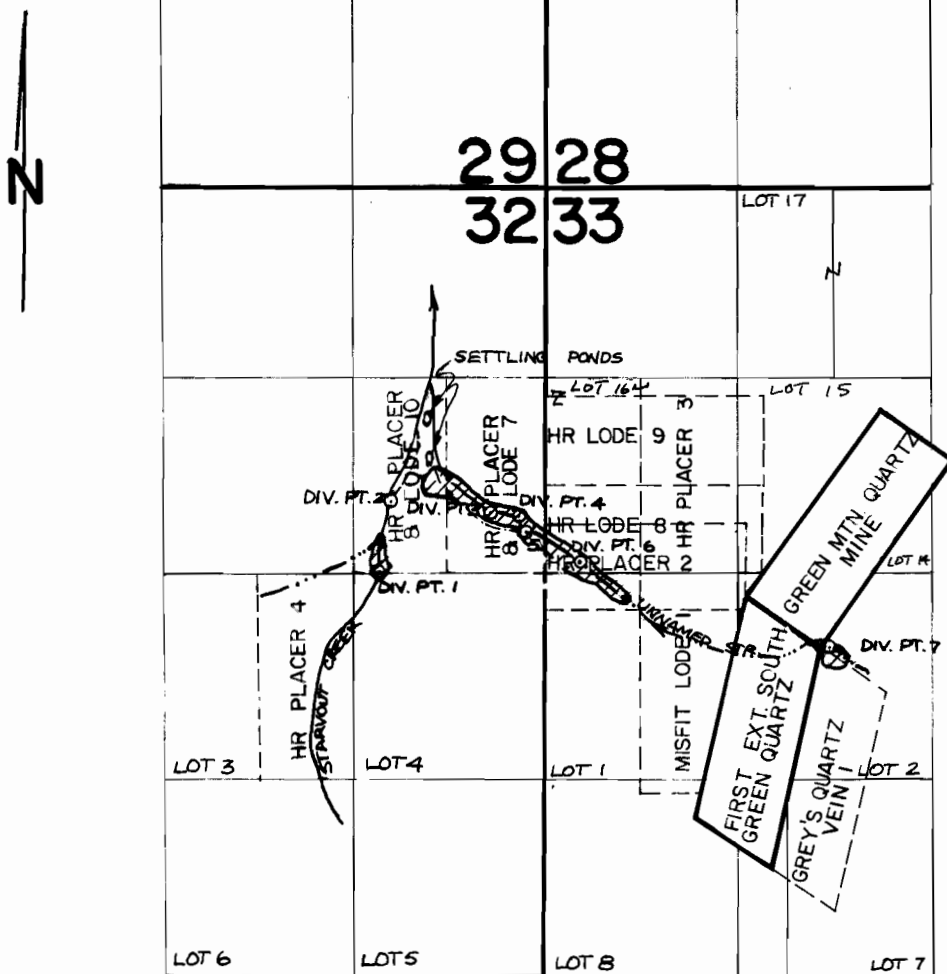

DIV. PT. 1 IS LOCATED 10' N. & 1140' W. FROM E 1/4 COR. SEC. 32.

"	"2"	"490' N. & 1060' W."	"
"	"3"	"410' N. & 375' W."	"
"	"4"	"390' N. & 180' W."	"
"	"5"	"280' N. & 140' W."	"
"	"6"	"75' N. & 240' E."	"
"	"7"	"500' S. & 1960' E."	"

SCALE : 4" = 1 MILE

FINAL PROOF SURVEY

UNDER

Application No. ..63452. Permit No. ..47407.....
IN NAME OF

.....WARREN D. WARD.....

Surveyed 4/23 & 29, 19.87., by ..J.M. SCHMORDE..