


T. 29 S., R. 14 W., W.M.

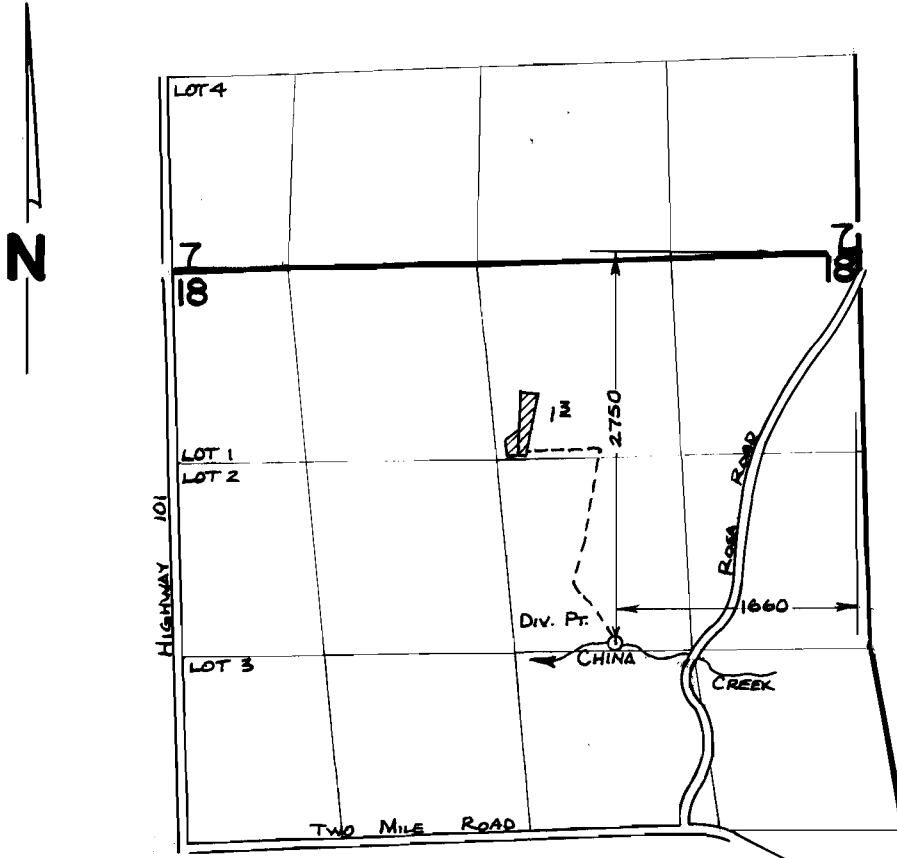

SCALE : 4" = 1 MILE

FINAL PROOF SURVEY UNDER

Application No.63610. Permit No.47411.....
IN NAME OF

.....BILL.....MANES.....

Surveyed4/21.... 19.88., byM..SCHMORDE..