




T. 33 S., R. 9 W., W.M.

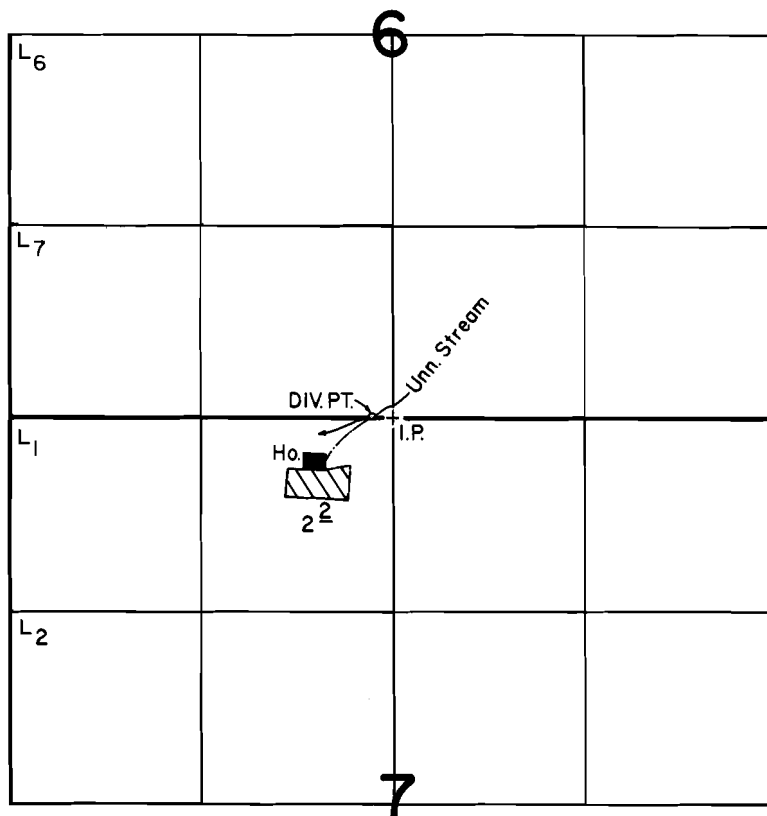

DIV. PT. LOC.: 10' N. & 140' W. FROM S1/4 CORNER SECTION 7

SCALE: 1" = 1320'

FINAL PROOF SURVEY UNDER

Application No. 63689. Permit No. 46877.
IN NAME OF

JAN & FRANK MOODY

Surveyed AUG. 17, 1988, by B. S. JAMES