


T. 9 S., R. 6 W., W.M.

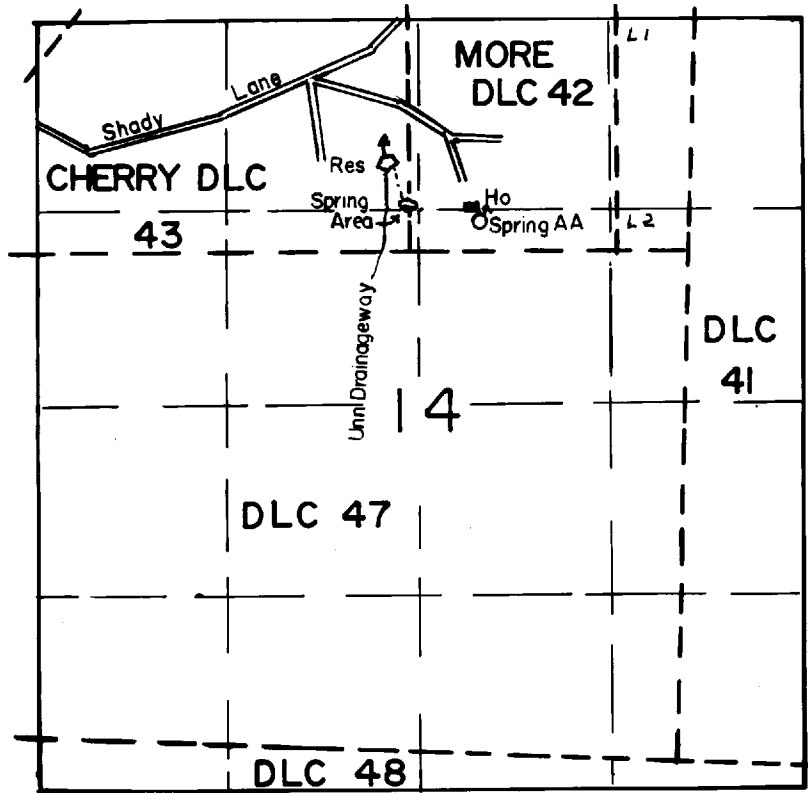

Spring Loc 200' N & 500' E, Spring Area Loc 350' N, Res Loc 650' & 170' W
 All From SE Corner DLC 43

SCALE: 1"=1320'

FINAL PROOF SURVEY
 UNDER

R-64599 R-8595
 Application No. 64600..... Permit No. 47321.....
 IN NAME OF

.....
 Surveyed JUNE 2..... 1989., by J.M. WARREN.....