




T. 32 S., R. 15 W., W.M.

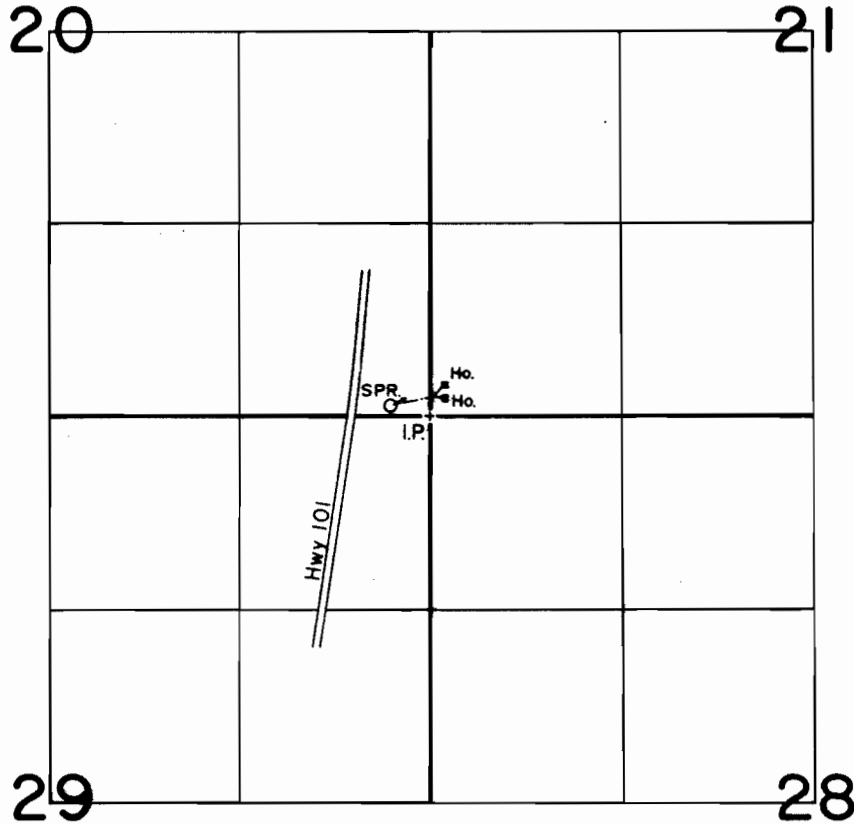

DIV. PT. LOC.: 60' N. & 270' W. FROM S.E. CORNER SECTION 20

SCALE: 1" = 1320'

**FINAL PROOF SURVEY**  
UNDER

Application No. 67512... Permit No. 48246...  
IN NAME OF

**FRANK R. & MARION F. ROMERO**

Surveyed JUNE 25 1988, by B. S. JAMES