


T.8N, R.8W, W. M.

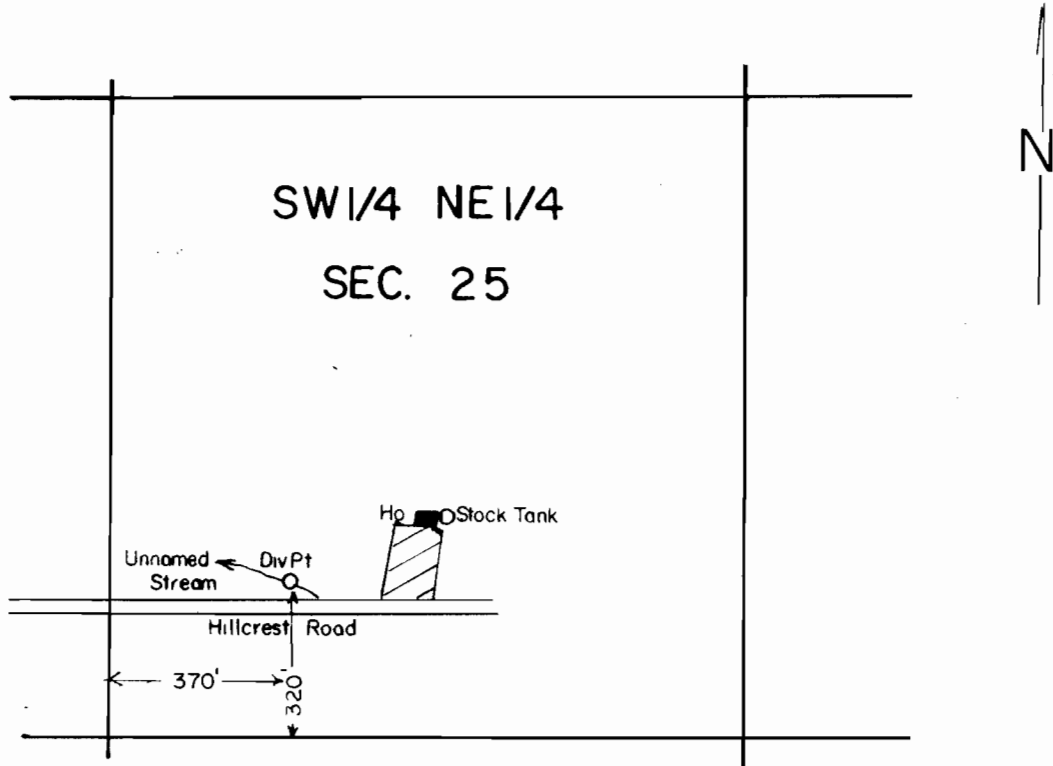

SCALE: 1" = 400'

FINAL PROOF SURVEY
UNDER

Application No. 68438... Permit No. 49421.....
IN NAME OF

.....**GERALD**.....**TOMLINSON**.....

Surveyed **JUNE 20, 1989**, by **J.M. WARREN**.....