

Application No. 69253  
Permit No. 50141


RECEIVED

AUG 25 1987

WATER RESOURCES DEPT.  
SALEM, OREGON



T. 4 S., R. 2 E., W.M.

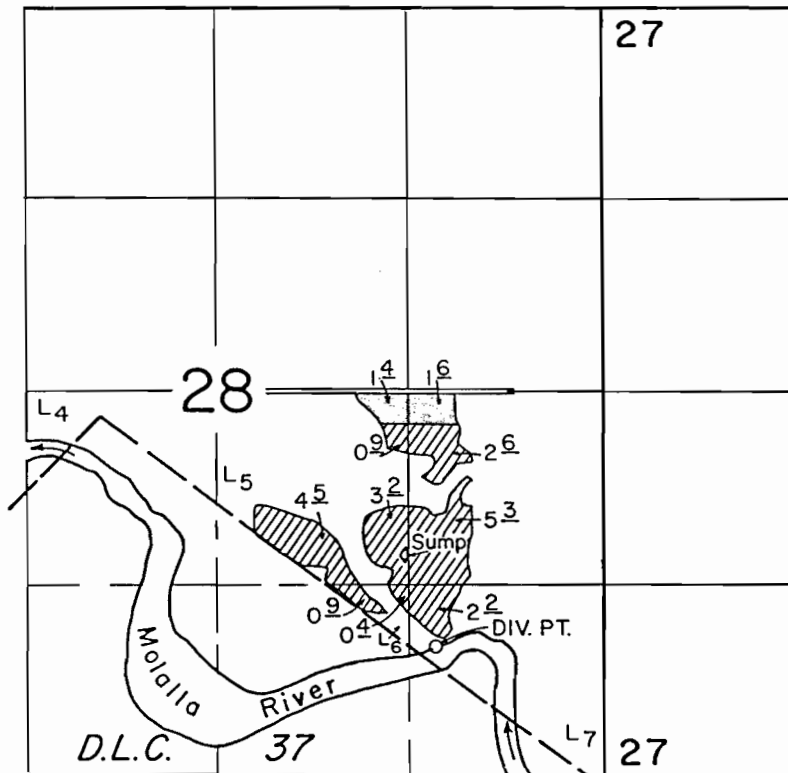

DIV. PT. LOC.: 900' N. & 1140' W. FROM THE S.E. CORNER SEC. 28

SCALE: 1" = 1320'

~~FINAL PROOF SURVEY~~  
~~UNDER~~

~~Application No. 64520, Permit No. 47185~~

IN NAME OF

GARY FENSTERMACHER

~~Surveyed JULY 10, 1985, by T. WARREN~~