
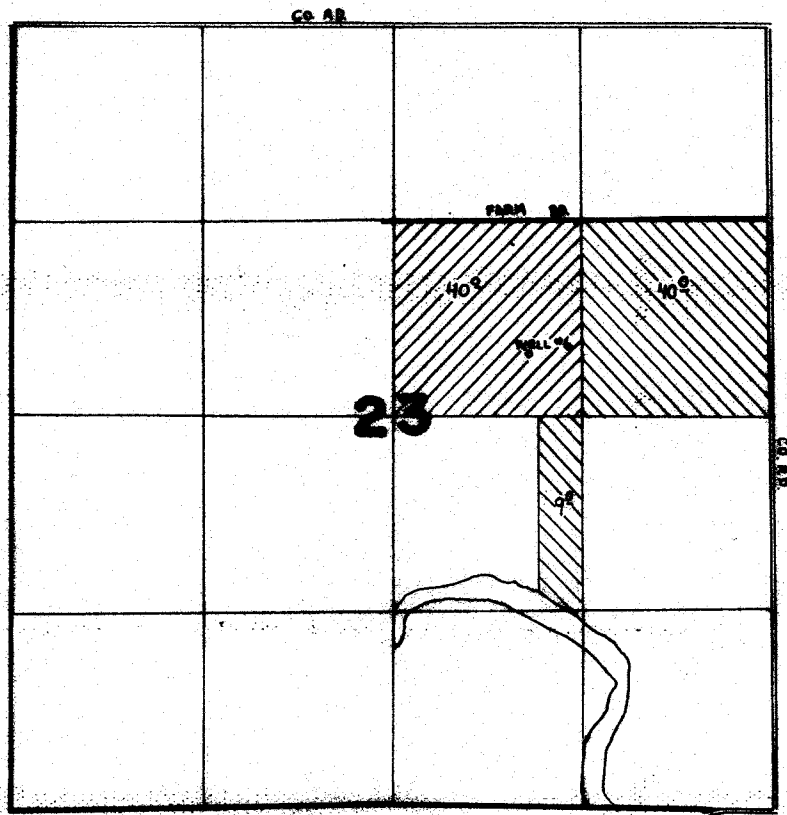


G-9939
63676

T. 6 N. R. 34 E. W.M.

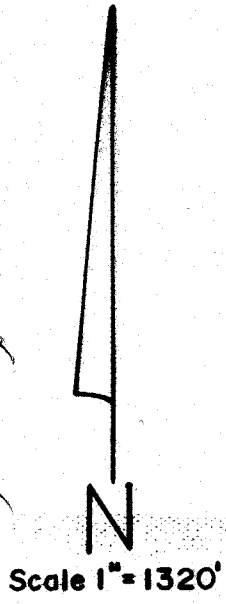

FINAL PROOF SURVEY UNDER

Application No. G.6607 Permit No. G.9939.....
IN NAME OF

.....HOWARD L. MULLER.....

Surveyed Nov. 24.. 1986, by V. Church.....